



TOWN OF NORTH CASTLE

WESTCHESTER COUNTY
17 Bedford Road
Armonk, New York 10504-1898

RESIDENTIAL PROJECT
REVIEW COMMITTEE
Adam R. Kaufman AICP, Chair

Telephone: (914) 273-3000 x 43
Fax: (914) 273-3554
www.nortcastleny.com

RESIDENTIAL PROJECT REVIEW COMMITTEE (RPRC) APPLICATION

Section I - PROJECT

ADDRESS: 109 Round Hill Rd Armonk NY 10504

Section III - DESCRIPTION OF WORK:

The existing PVC fence on my property encroaches on my neighbors property on the left side when facing the house from Round Hill Rd. I will be moving the portion of the fence to reposition within my property boundary as marked in red on the survey attached.

Section III - CONTACT INFORMATION:

APPLICANT: Jacqueline Bhavaraju
ADDRESS: ~~109 Round Hill Rd A~~ 7 Maryland Ave, Armonk NY 10504
PHONE: 347-725-2869 MOBILE: 347-725-2869 EMAIL: jacqueline.bhavaraju@gmail.com

PROPERTY OWNER: Jacqueline Bhavaraju
ADDRESS: 7 Maryland Ave Armonk NY 10504
PHONE: 347-725-2869 MOBILE: 347-725-2869 EMAIL: jacqueline.bhavaraju@gmail.com

PROFESSIONAL: _____


ADDRESS: _____

PHONE: _____ MOBILE: _____

EMAIL: _____

Section IV - PROPERTY INFORMATION:

Zone: R-2A Tax ID (lot designation) 109.01-1-33

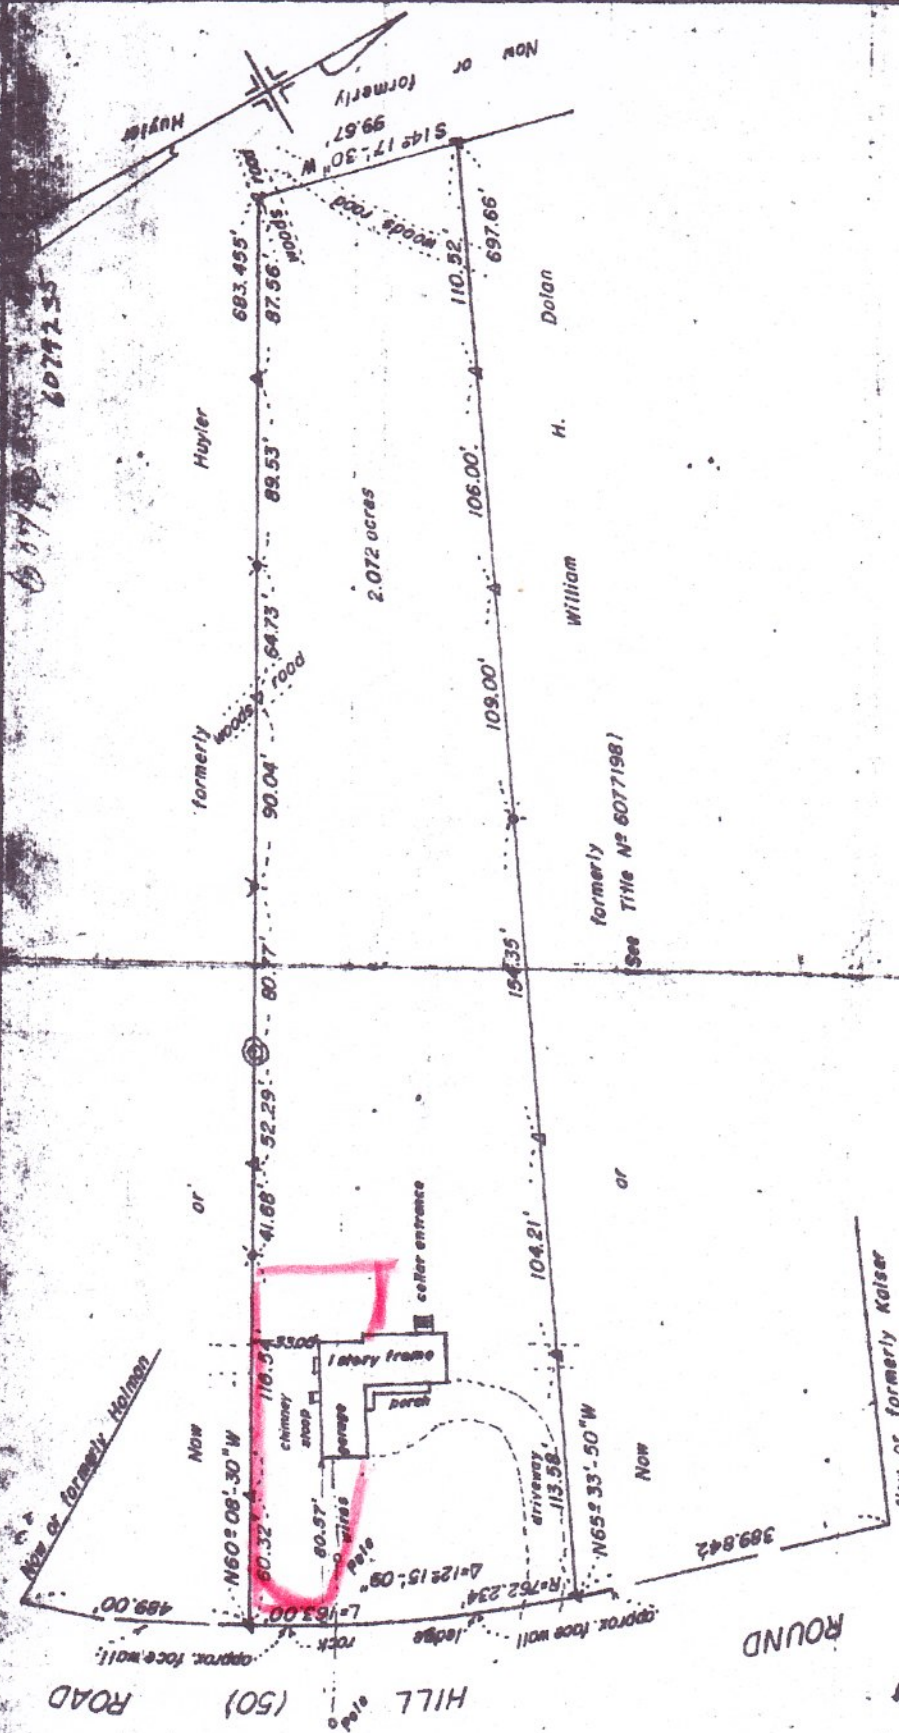

60771981

HILL ROAD (50)

SURVEY OF PROPERTY TO BE CONVEYED TO

THEODORE & HELEN MATYAS

TOWN OF NORTH CASTLE
WESTCHESTER CO., N.Y.
SCALE 1"=60'

Certified to The Title Guarantee Company

I, J.L. Wilson, the surveyor who made this map, do hereby certify that the survey of the property shown hereon was completed May 11, 1960. Revised Aug. 10, 1966 revised Oct. 17, 1966.

J. L. Wilson
License No 10025, South Salem, N.Y.

Legend
 Δ indicates stake set
 p indicates drillhole
 ⊗ indicates tack in tree

formerly William H. Dolan
 (See Title No 60771981)

95519

2850700
 1000000



