

# TOWN OF NORTH CASTLE

WESTCHESTER COUNTY 17 Bedford Road Armonk, New York 10504-1898

RESIDENTIAL PROJECT REVIEW COMMITTEE Adam R. Kaufman AICP, Chair Telephone: (914) 273-3000 x43 Fax: (914) 273-3554 www.northcastleny.com

## **RESIDENTIAL PROJECT REVIEW COMMITTEE (RPRC) PROCEDURES**

The RPRC was created to streamline the residental review process and quickly reviews all residential projects. Projects determined to have no impact are permitted to apply to the Building Department while more complicated projects are directed to the appropriate review board(s).

THE RPRC reviews all applications for residential permits (including, but not limited to, buildings permits, steep slope permits, wetlands permits and pool permits), but excluding permits only relating to interior alterations/renovations.

To get on an RPRC agenda you must submit a single PDF file containing the following to the Planning Department:

- 1. Complete all items on the RPRC checklist
- 2. RPRC Application fee. Check made payable to: Town of North Castle.
- 3. Floor Area and Gross Land Coverage work sheets (with backup information)
- 4. Plans for your project according the RPRC Checklist
- 5. Submit one single PDF file containg all information listed above to the Planning Department: planning@northcastleny.com.

Once your application h as been submitted, you may follow your application on the RPRC webpage located at http://www.northcastleny.comlresidential-project-review-committee-rprc

Determination Letters are posted on the website (click on determination letters, find the date of your meeting and click on the name of your project - Letters are posted the day after the meeting, typically by 1 :00 p.m.)



Town of North Castle Residential Project Review Committee

17 Bedford Road Armonk, New York 10504 (914) 273-3542 (914) 273-3554 (fax)

## **RPRC COMPLETENESS REVIEW FORM**

This form represents the standard requirements for a completeness review for all Residential Project Review Committee submissions. Failure to provide all of the information requested will result in a determination that the application is incomplete.

Project Name on Plan: Varghese Residence					
Initial Submittal Revised Preliminary					
Street Location: 6 Fox Ridge Road					
Zoning District: R 1.5A Property Acreage: 1.563 Tax Map Parcel ID: 102.1-1-63					
Date: 9-29-22					
DEPARTMENTAL USE ONLY					
Date Filed: Staff Name:					
Preliminary Plan Completeness Review Checklist Items marked with a are complete, items left blank are incomplete and must be completed, "NA" means not applicable.					
1. Plan prepared by a registered architect or professional engineer					
2. Aerial photo (Google Earth) showing the applicant's entire property and adjacent properties and streets					
3. Map showing the applicant's entire property and adjacent properties and streets					
4. A locator map at a convenient scale					
5. The proposed location, use and design of all buildings and structures					
β. Existing topography and proposed grade elevations					
7. Location of drives					
3. Location of all existing and proposed site improvements, including drains, culverts, retaining walls and fences					



# TOWN OF NORTH CASTLE

WESTCHESTER COUNTY 17 Bedford Road Armonk, New York 10504-1898

RESIDENTIAL PROJECT REVIEW COMMITTEE Adam R. Kaufman AICP, Chair

Telephone: (914) 273-3000 x 43 Fax: (914) 273-3554 www.nortcastleny.com

### **RESIDENTIAL PROJECT REVIEW COMMITTEE (RPRC) APPLICATION**

Section I- PROJECT ADDRESS: U Fox PIDLE POAD. Section III- DESCRIPTION OF WORK: CHANDES TO PREVIOUS PERENT: NEW WWOONDS FORT/ POOF AT LIVING ROOM. NEW MNDOW SEAT/ POOF AT LIVING ROOM. NEW PODIMW AT DINING ROOM INTERIOK CHANGES.

Section III- CONTACT INFORMATION:

APPLICANT: MICHMOL	PICURINO AIZCHITO	DRE PLLC	
	TREET SUITE 203		HOTF. NY 10598
			Enplumillo prestition con
PROPERTY OWNER: JENSE	N VARCHESE		
ADDRESS: 6 For FIDE	e rond		
PHONE:	MOBILE:917-716-8074	EMAIL: JENSEN	NEGHNILION
PROFESSIONAL:: SIW	Nº 1 PPULANS		
ADDRESS:	•		
PHONE:	MOBILE:		
EMAIL:			
Section IV- PROPERTY IN	NFORMATION:		
Zone: RI.SA	Tax ID (lot designation)	102.01-1.	-63



PLANNING DEPARTMENT

Adam R. Kaufman, AICP Director of Planning TOWN OF NORTH CASTLE

WESTCHESTER COUNTY 17 Bedford Road Armonk, New York 10504-1898

> Telephone: (914) 273-3542 Fax: (914) 273-3554 www.northcastleny.com

### **GROSS LAND COVERAGE CALCULATIONS WORKSHEET**

Application Name or Identifying Title:	VARGHESE	Date: 9-1-22
Tax Map Designation or Proposed Lot No.	102.01-1-63	
Gross Lot Coverage		
1. Total lot Area (Net Lot Area for I	Lots Created After 12/13/06):	68,084.28
2. Maximum permitted gross land c	overage (per Section 355-26.C(1)(b)):	11,557.19
3. BONUS maximum gross land cor	ver (per Section 355-26.C(1)(b)):	
Distance principal home is beyon $2^{1}$ x 10 =	d minimum front yard setback	210
4. TOTAL Maximum Permitted g	ross land coverage = Sum of lines 2 and 3	11,767.19
5. Amount of lot area covered by pr $\frac{2153}{2153}$ existing + $500$	incipal building: proposed =	2,653
6. Amount of lot area covered by <b>ac</b> $ \underbrace{\overset{0}{}}_{0} \text{ existing } + \underbrace{\overset{0}{}}_{0} $		0
7. Amount of lot area covered by <b>de</b> $  \underbrace{\overset{0}{\qquad}}_{\text{existing } + \underbrace{\overset{0}{}}_{\text{existing } + \overset{0$		0
<ol> <li>Amount of lot area covered by po <sup>0</sup> existing + <sup>0</sup> </li> </ol>	proposed =	0
	iveway, parking areas and walkways:	2391
10. Amount of lot area covered by ten $\frac{291}{291} = existing + 0$		291
11. Amount of lot area covered by ten	nnis court, pool and mechanical equip: proposed =	0
12. Amount of lot area covered by <b>all</b> <sup>0</sup> existing + <sup>0</sup>		0
13. Proposed gross land coverage:	• 0.00 • 0.12 Meddad D	2,335

If Line 13 is less than or equal to Line 4, your proposal **complies** with the Town's maximum gross land coverage regulations and the project may proceed to the Residential Project Review Committee for review. If Line 13 is greater than Line 4 your proposal does not comply with the Town's regulations.

9-1-22

Signature and Seal of Professional Preparing Worksheet

Date



### TOWN OF NORTH CASTLE

WESTCHESTER COUNTY 17 Bedford Road Armonk, New York 10504-1898

PLANNING DEPARTMENT Adam R. Kaufman, AICP Director of Planning January 29, 2019 Telephone: (914) 273-3542 Fax: (914) 273-3554 www.northcastleny.com


## FLOOR AREA CALCULATIONS WORKSHEET

Application Name or Identifying Title:	ARGHESE	Date: 9/1/22
Tax Map Designation or Proposed Lot No.: 10	02.01-1-63	
Floor Area		
1. Total Lot Area (Net Lot Area for Lots	s Created After 12/13/06):	68,084.28
2. Maximum permitted floor area (per S	Section 355-26.B(4)):	9,171.21
3. Amount of floor area contained within $\frac{1,720}{289}$ p	n first floor: proposed =	2,009
4. Amount of floor area contained within $\frac{895}{2}$ existing $+ \frac{527}{2}$ p	n second floor: proposed =	1,422
5. Amount of floor area contained within $\frac{433}{211}$ existing $+ \frac{211}{211}$ p	n garage: proposed =	644
6. Amount of floor area contained within _ 0 existing + 0 p	n porches capable of being enclosed: proposed =	0
	n basement (if applicable – see definition): proposed =	0
8. Amount of floor area contained within existing + NA p	n attic (if applicable – see definition): proposed =	0
9. Amount of floor area contained within existing + p	• •	0
10. Pro posed <b>floor area:</b> Total of Lines 3	-9=	4,075

If Line 10 is less than or equal to Line 2, your proposal **complies** with the Town's maximum floor area regulations and the project may proceed to the Residential Project Review Committee for review. If Line 10 is greater than Line 2 your proposal does not comply with the Town's regulations.

Signature and Seal of Professional Preparing Worksheet

9/1/22 Date

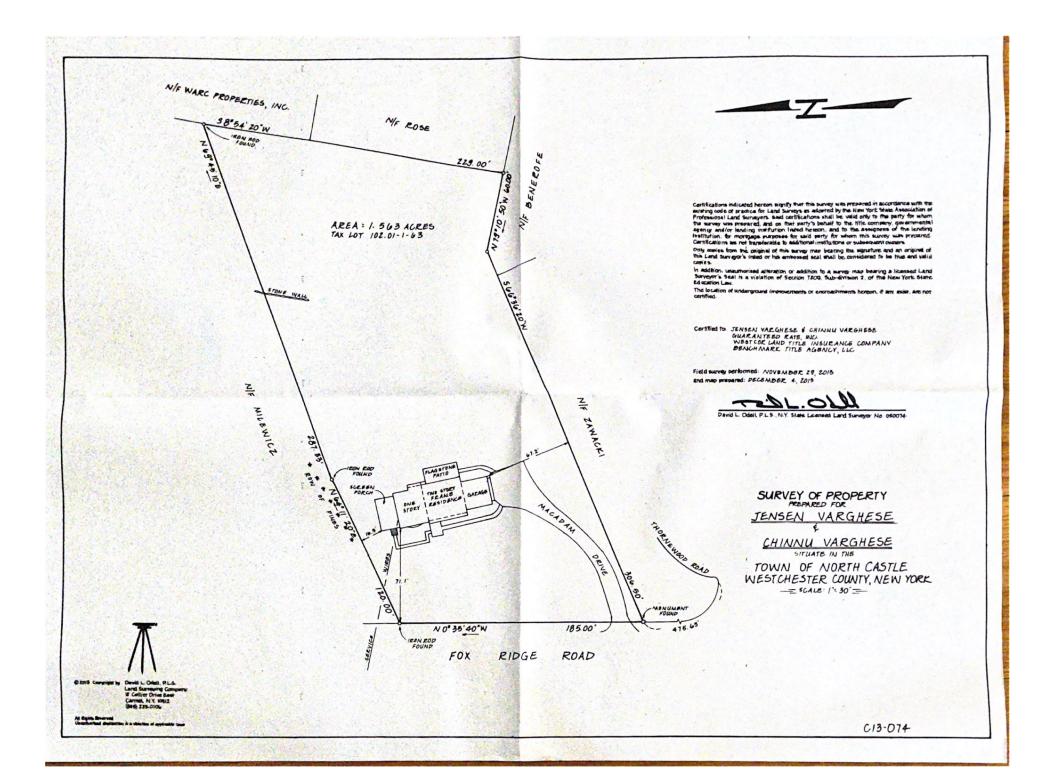



ZONING DATA: NORTH CASTLE


TAX MAP #: 102.01-1-63						
ZONE: R - 1.5A						
TABLE BUILDING REQUIREMENTS						
	REQUIRED	EXISTING	PROPOSED	VARIANCE		
MINIMUM LOT AREA	1.5 ACRE	68,084.28SF	NO CHANGE	NO		
FRONTAGE	150 FT	185 FT	NO CHANGE	NO		
MINIMUM LOT WIDTH	150 FT	185.0 FT	NO CHANGE	NO		
MINIMUM LOT DEPTH	150 FT	287.33 FT	NO CHANGE	NO		
MAX HEIGHT	2.5 STORIES 30 FEET	2 STORY 21 FT	2 STORY 21 FT	NO		
MAX BUILDING COVERAGE	10% 6,808.428SF	3.16% 2,156 SF	3.78 % 2,576 SF	NO		
MAX GROSS FLOOR AREA	REFER TO CALCULATION WORKSHEET					
MAX GROSS LAND COVERAGE	REFER TO CALCULATION WORKSHEET					
SETBACK REQUIREMENTS						
MIN. FRONT	50'-0"	71.1'	71.1'	NO		
MIN. REAR	40'-0"	244'	230'	NO		
MIN. SIDE (NORTH)	30'-0"	16.5' *	16.5' *	NO		
MIN. SIDE (SOUTH)	30'-0"	67.2'	54.0'	NO		


EXISTING NON-CONFORMING


\*

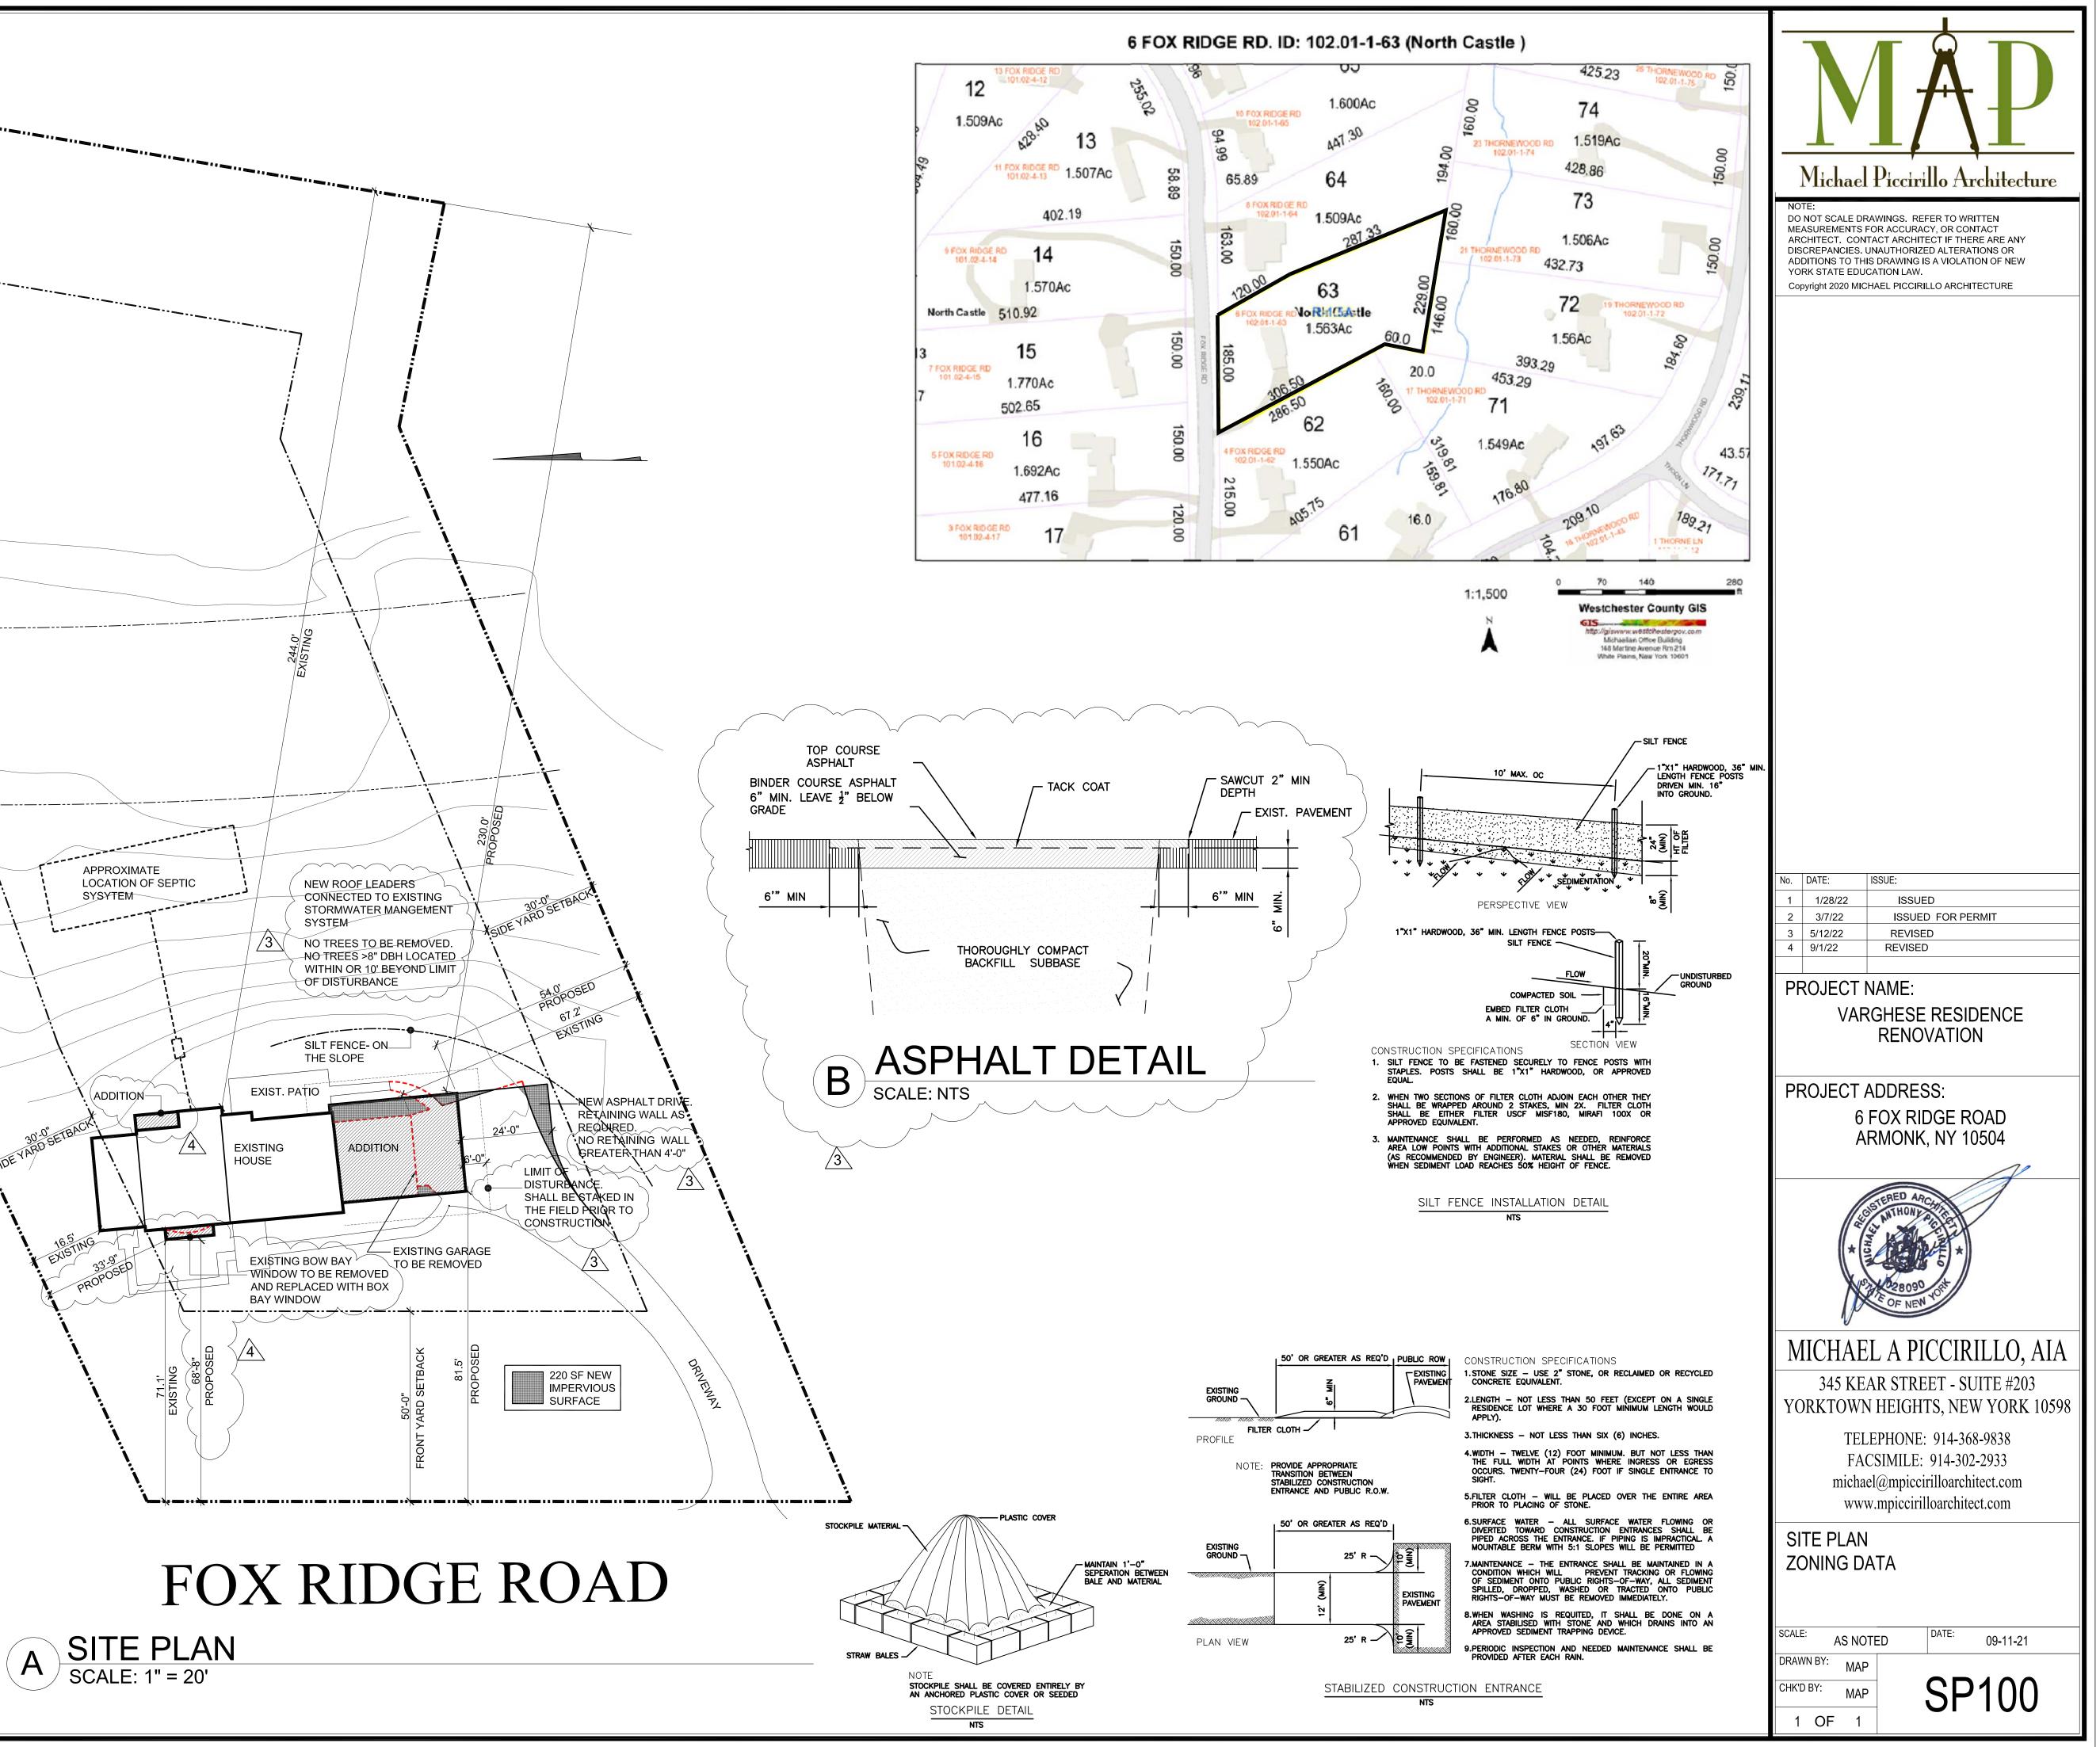


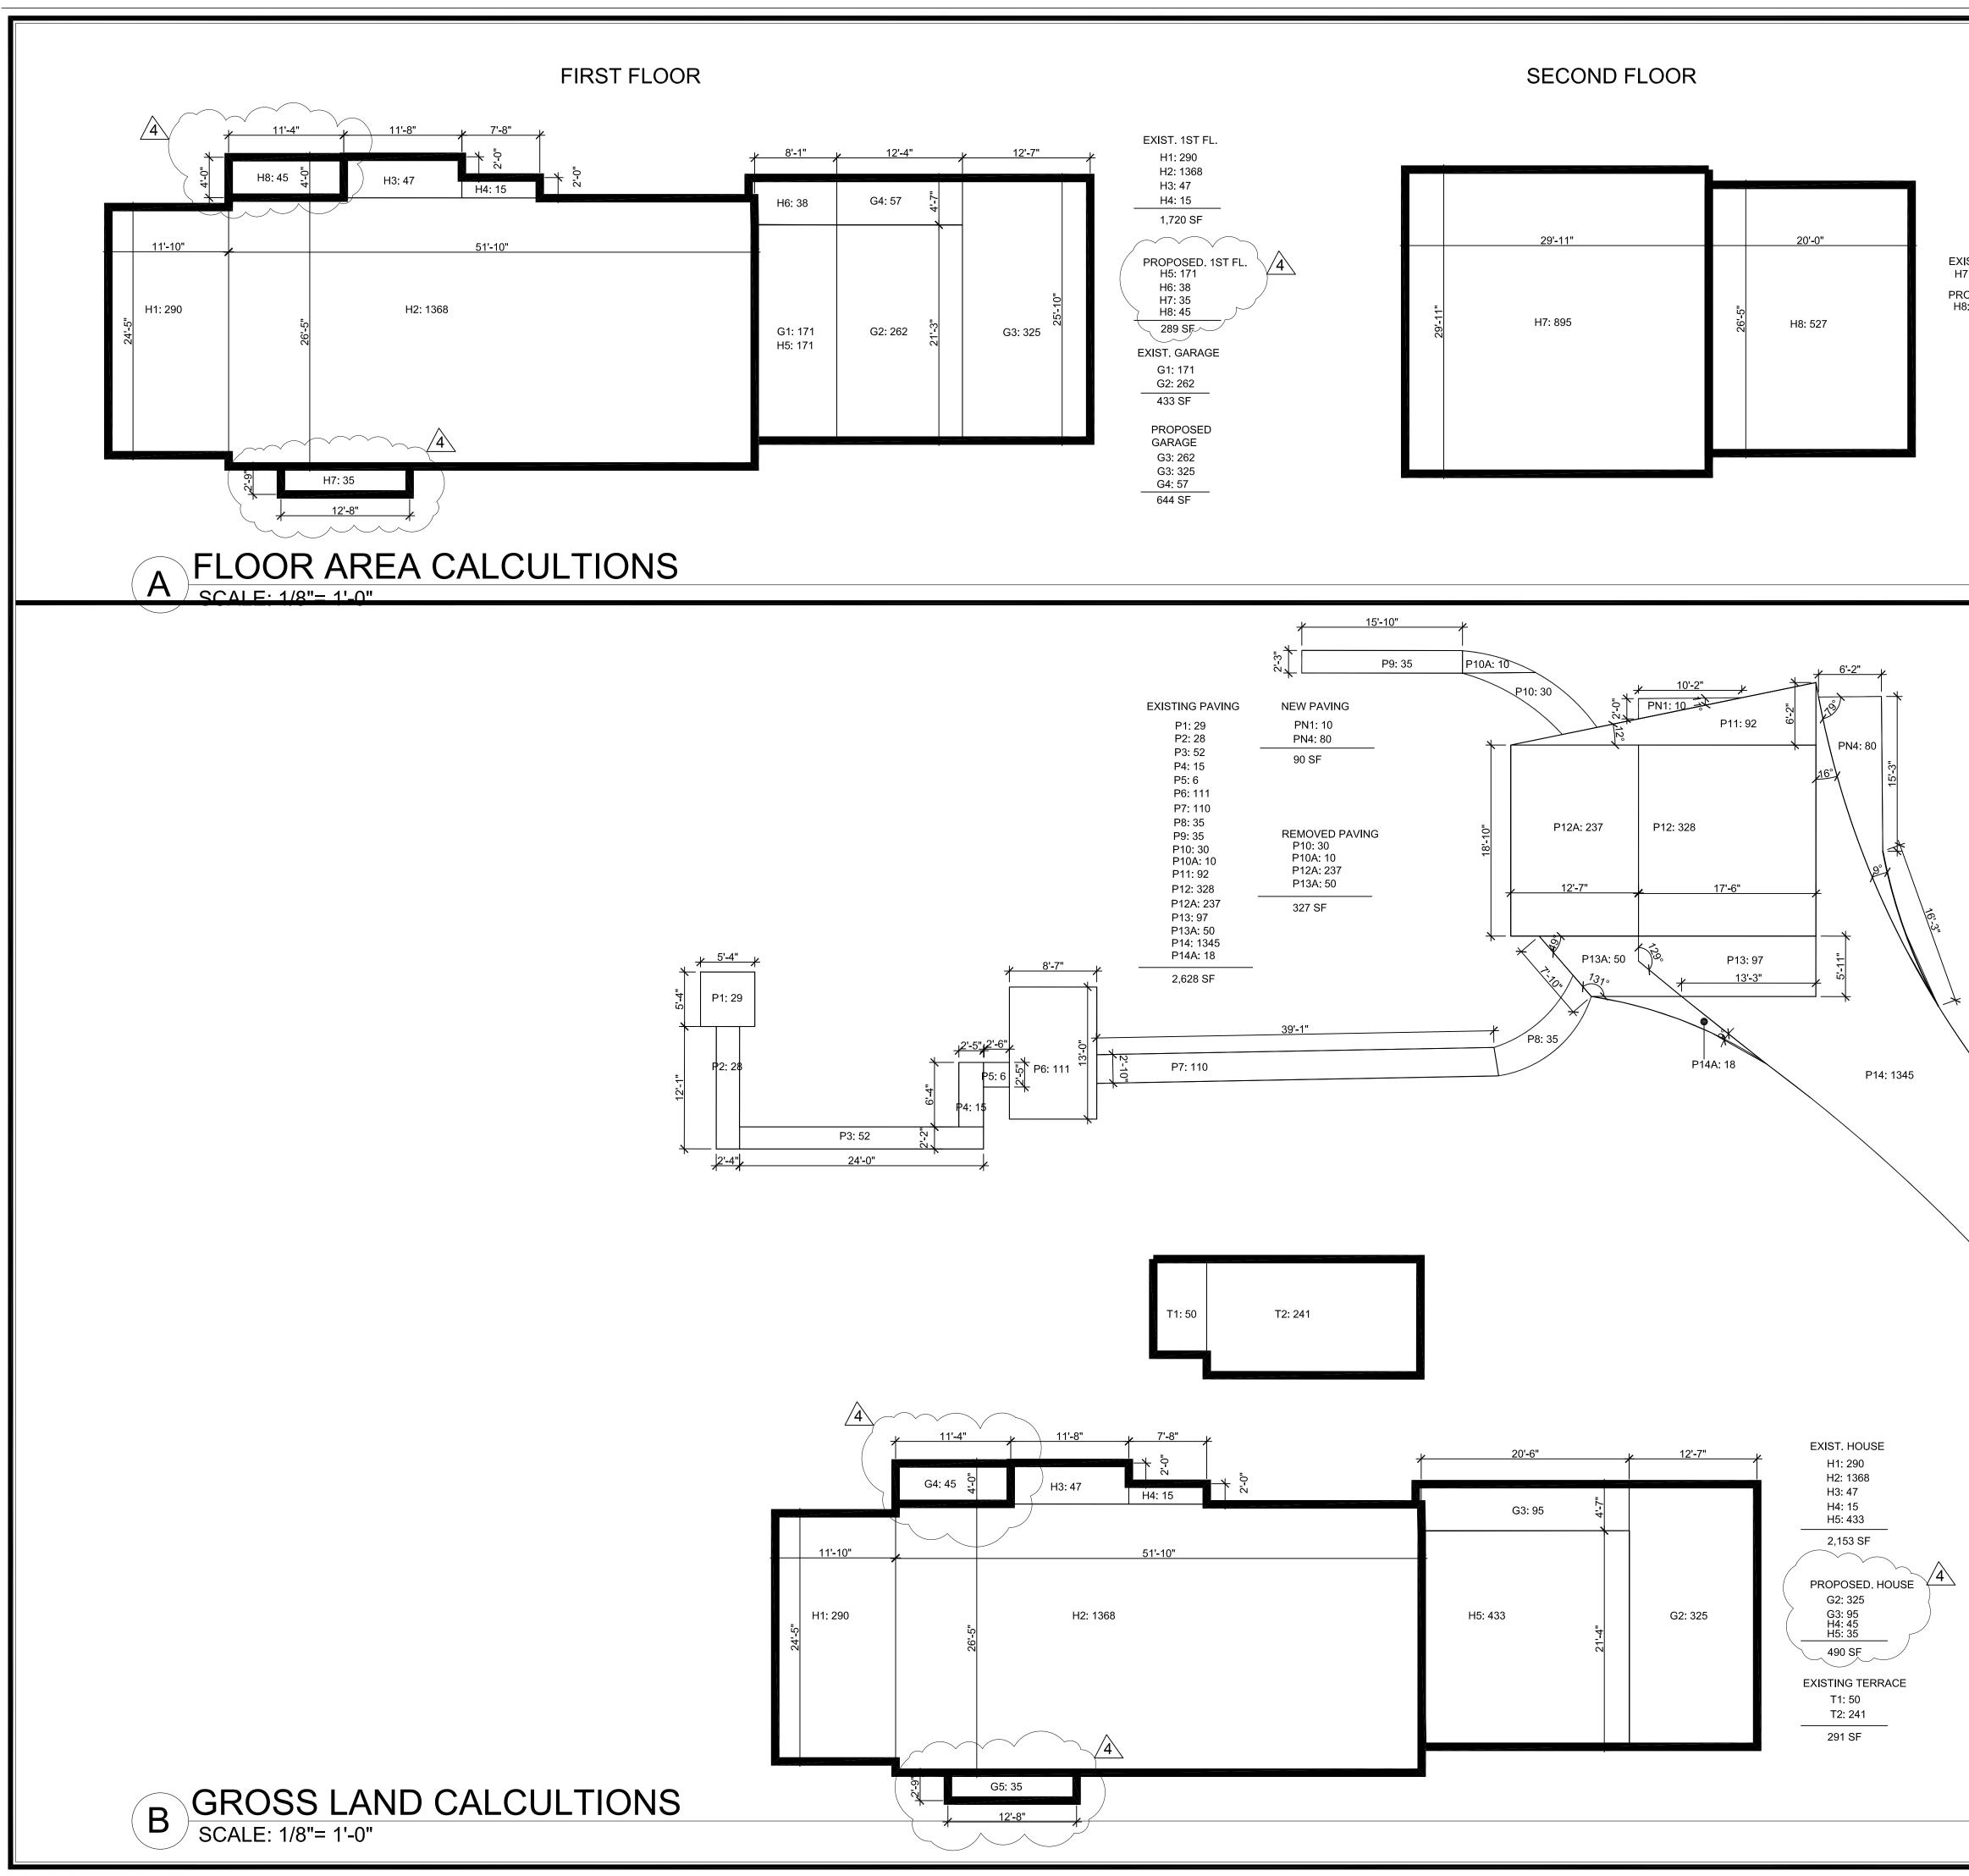

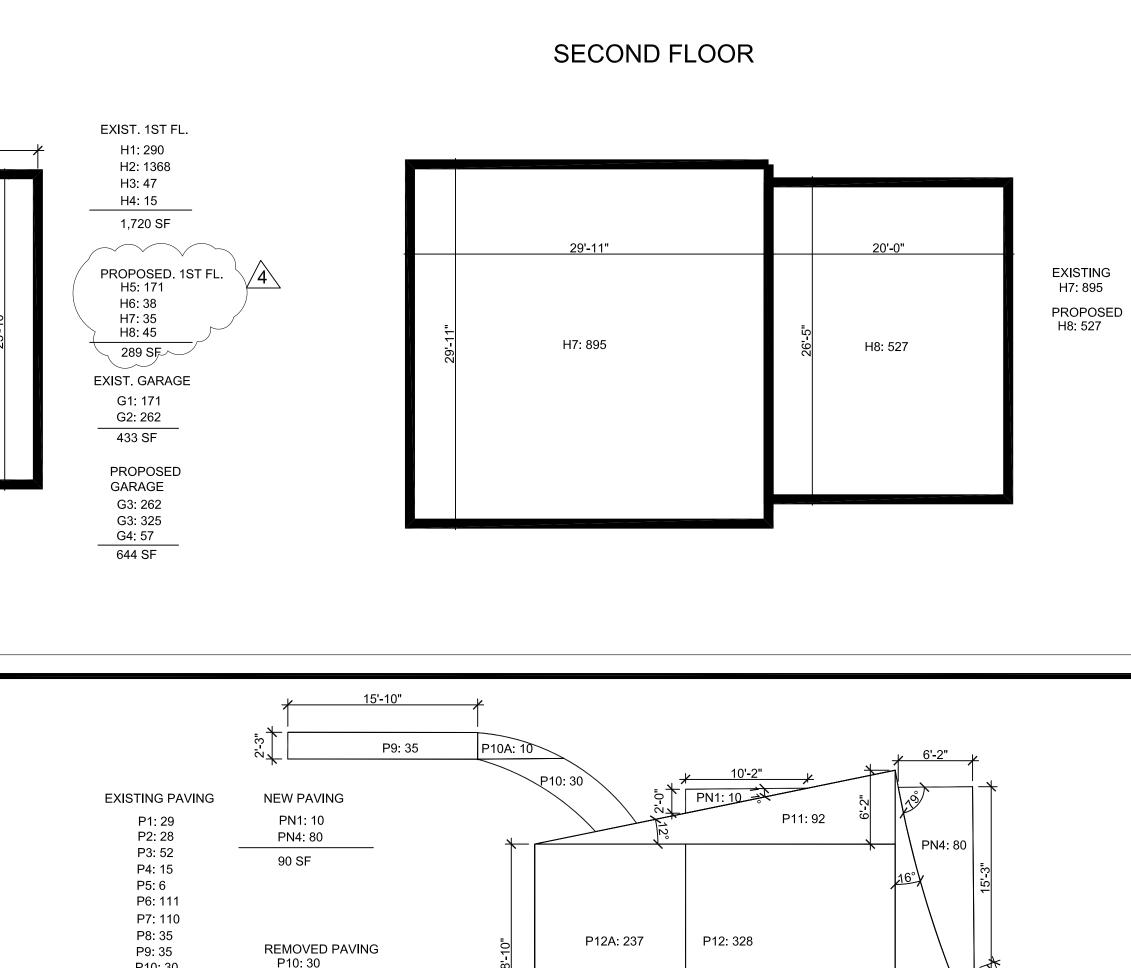

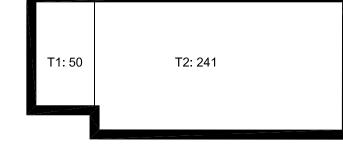

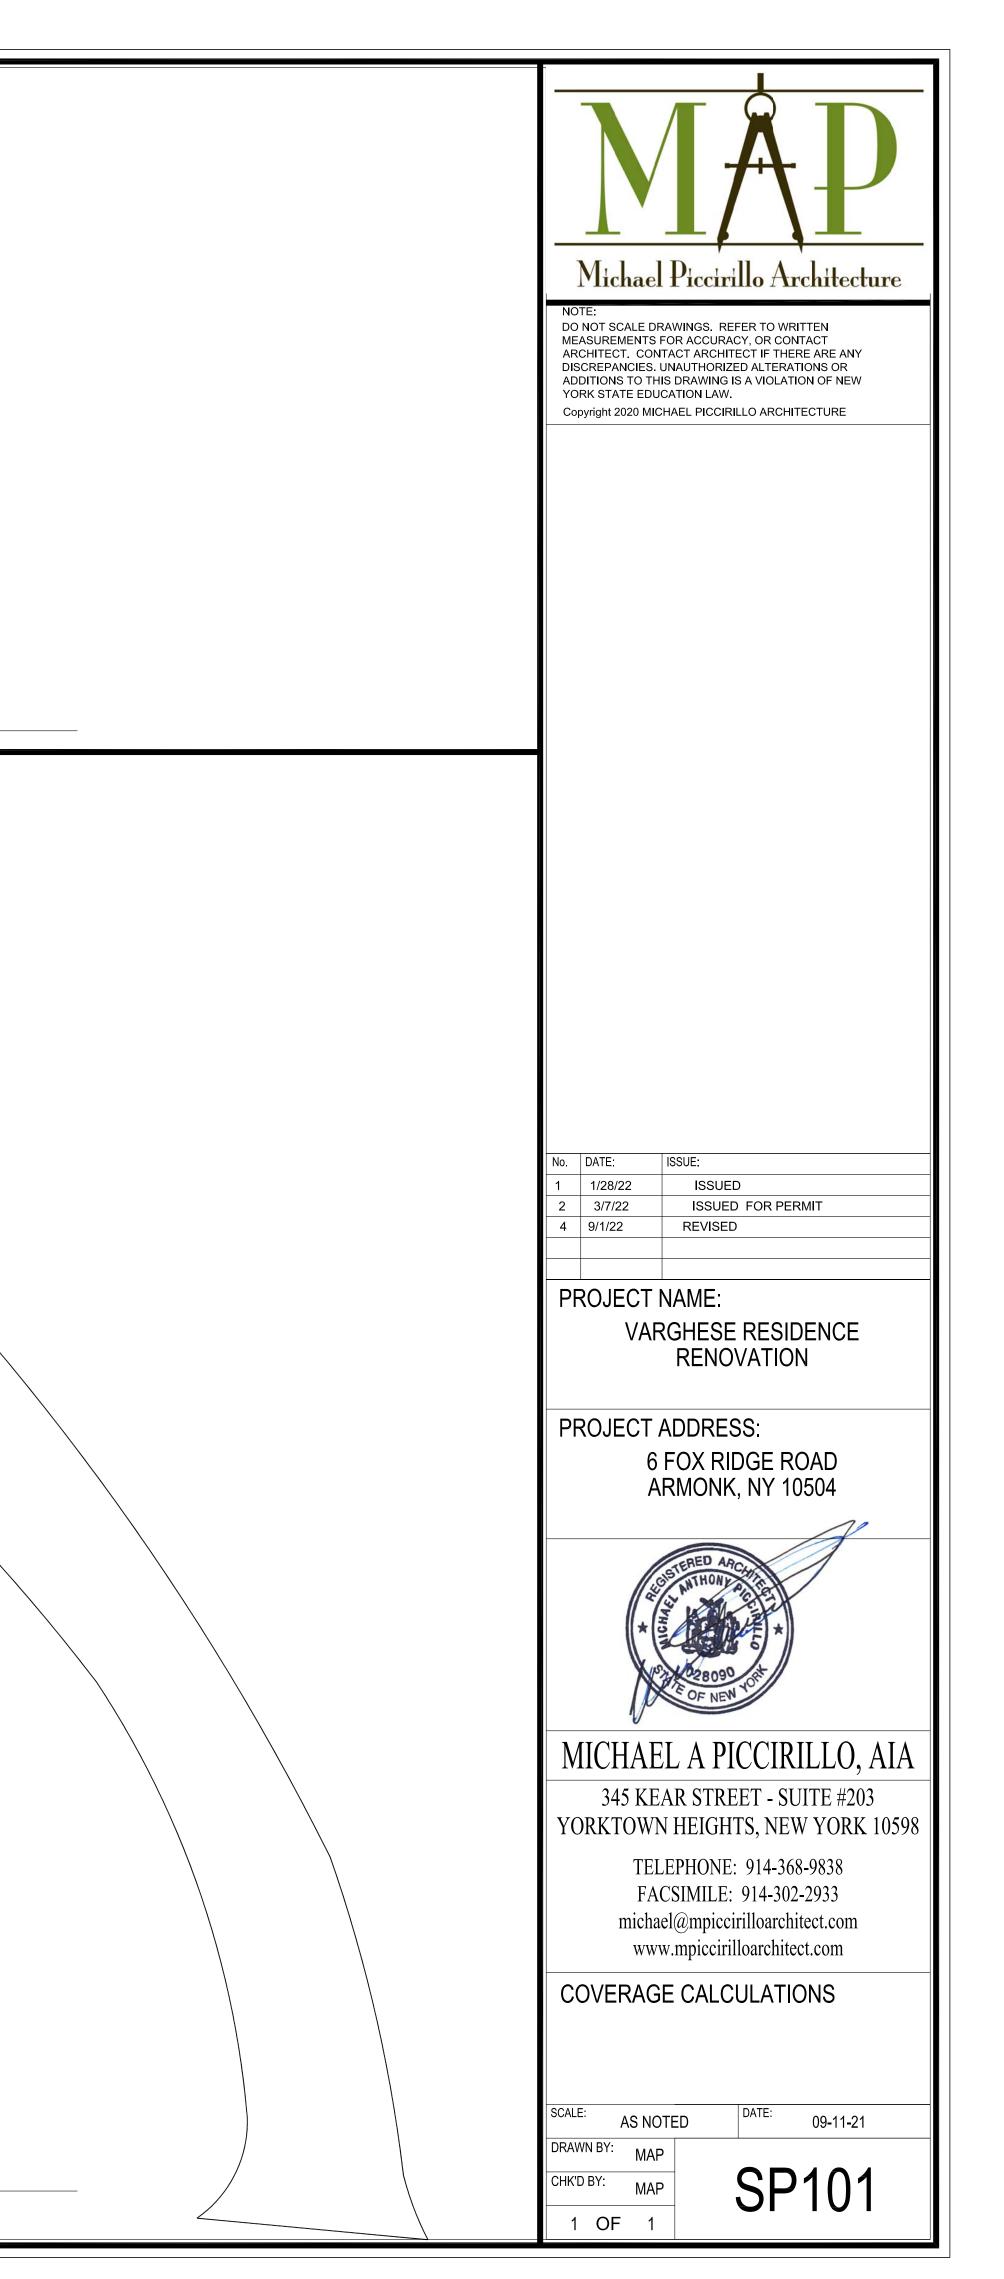

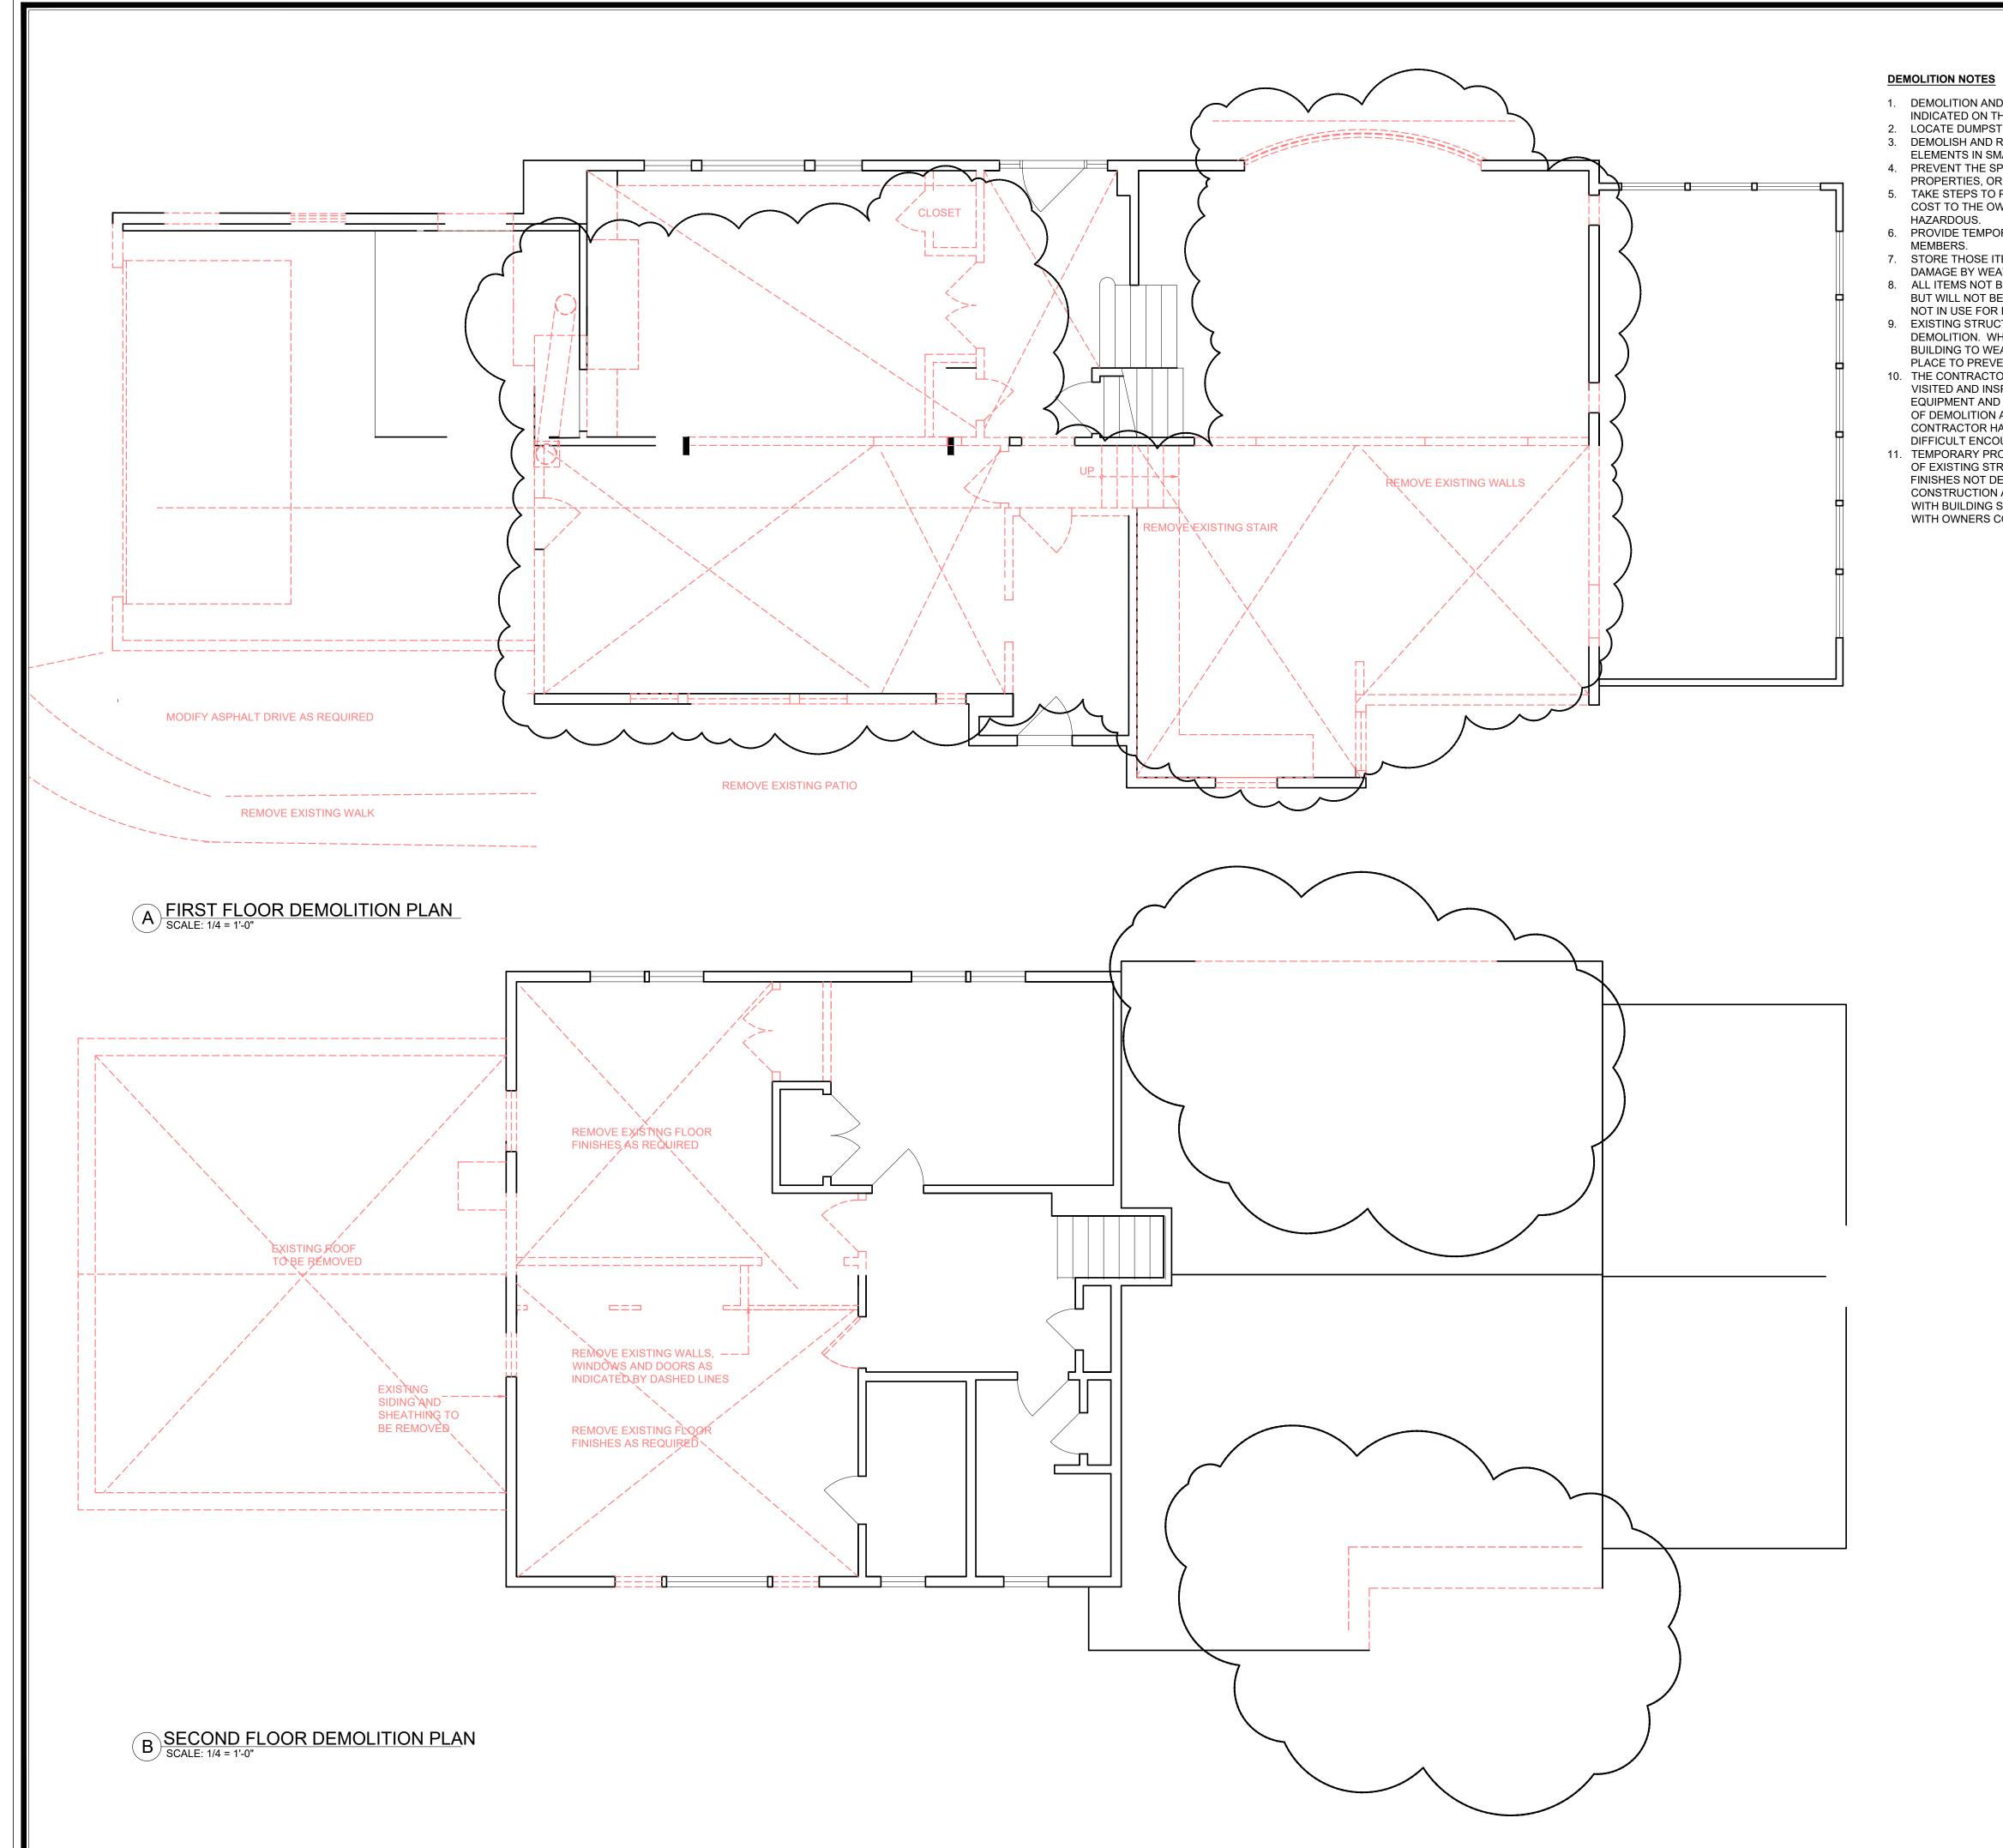

1. DEMOLITION AND REMOVAL OF INTERIOR AND EXTERIOR WALLS, CEILINGS, ROOF, ETC., AS INDICATED ON THE DRAWINGS. 2. LOCATE DUMPSTER AS INDICATED ON SITE PLAN.

3. DEMOLISH AND REMOVE INDICATED AREAS IN A SAFE AND ORDERLY WAY, REMOVING

ELEMENTS IN SMALL PIECES. USE NO EXPLOSIVES. 4. PREVENT THE SPREAD OF DUST OR DEBRIS TO UNAFFECTED PARTS OF THE SITE, ADJACENT PROPERTIES, OR PUBLIC STREETS. CLEAN UP ANY DUST OR DEBRIS SPREAD BY DEMOLITION. 5. TAKE STEPS TO PROTECT EXISTING CONDITIONS TO REMAIN. REPAIR ANY DAMAGE AT NO COST TO THE OWNER. PROTECT AND MARK ALL NEW OPENINGS, WHICH COULD BE


6. PROVIDE TEMPORARY SUPPORT WHERE REQUIRED FOR REMOVAL OF STRUCTURAL 7. STORE THOSE ITEMS INDICATED TO BE SAVED SO THAT THEY ARE PROTECTED FROM

DAMAGE BY WEATHER OR FURTHER CONSTRUCTION ACTIVITIES. 8. ALL ITEMS NOT BEING USED SHALL BE REMOVED. ANY AND ALL ITEMS PRESENTLY IN USE BUT WILL NOT BE UTILIZED SHALL BE REMOVED. G.C. SHALL V.I.F. ALL ITEMS CURRENTLY NOT IN USE FOR DEMOLITION.

9. EXISTING STRUCTURE SHALL BE MAINTAINED IN A WEATHER TIGHT CONDITION THROUGHOUT DEMOLITION. WHERE ITEMS DEEMED TO BE REMOVED SHALL EXPOSE INTERIOR OF BUILDING TO WEATHER ELEMENTS, MEASURES, PROTECTION AND SCHEDULING SHALL TAKE PLACE TO PREVENT DAMAGE TO ITEMS TO REMAIN.

10. THE CONTRACTOR SHALL FULLY ACQUAINT HIMSELF WITH THE EXISTING AND SHALL HAVE VISITED AND INSPECTED THE JOB SITE AND BE FULLY INFORMED AS TO THE NATURE OF EQUIPMENT AND FACILITIES NEEDED FOR THE PROPER EXECUTION OF THE WORK. STARTING OF DEMOLITION AND REMOVAL OPERATIONS WILL BE CONSTRUED AS EVIDENCE THAT THE CONTRACTOR HAS COMPILED WITH THESE REQUIREMENTS AND LATER CLAIMS FOR DIFFICULT ENCOUNTERED WHICH COULD HAVE BEEN FORESEEN WILL NOT BE RECOGNIZED. 11. TEMPORARY PROTECTION: PARTICULAR ATTENTION SHALL BE GIVEN TO THE PROTECTION OF EXISTING STRUCTURE AND FINISHES SO AS TO PREVENT ANY DAMAGE OF EXISTING FINISHES NOT DESIGNATED FOR DEMOLITION. PROVIDE ALL NECESSARY TEMPORARY CONSTRUCTION AND DUST PROOF PROTECTION. PROTECTION SHALL BE IN COMPLIANCE WITH BUILDING STANDARDS, TYPE AND LOCATION OF PROTECTION SHALL BE REVIEWED WITH OWNERS CONSTRUCTION REPRESENTATIVE PRIOR TO COMMENCING WORK.

			T	
			Å	$\mathbf{P}$
]	Michael	Picciri	llo Ar	chitecture
FOR IF TH UNAU A VIC	NOT SCALE DR ACCURANCY, HERE ARE ANY	OR CONTACT DISCECPENC ERATIONS OR EW YORK STA	ARCHITECT. IES ADDITIONS TE EDUCATIO	
N N	VALL AND DO	OR SYMBOL	S	
		EXISTING W	_	EMAIN
	///////////////////////////////////////			ONSTRUCTED. ON FOR DETAILS
		EX. DOOR T	O REMAIN	
	$\left[ \right]$	NEW DOOR	TO BE INS	TALLED
	∎ E	NEW CONC	RETE FOU	NDATION WALL
				LL TO REMAIN
║ └──		EX. WALL TO		
<b>-</b>		L/		
				Y
		ERED ARCAN		1
	MICHA,			
		028090		
	le la	OF NEV		
No.	DATE: 8/31/22	ISSUE: ISSUED F		CHANGES
PF	ROJECT VAR	NAME: GHESE		
		IOVATIC		-
		<u> </u>	יסר.	
	ROJECT / 6	ADDRES		DAD
	-	-	-	K 10504
	ΤΛΤΓΛΤ	זת א יי	מזריבי	
IVI				ILLO, AIA
		EAR STRÌ Iown, N		RK 10598
		LEPHONE		
		CSIMILE: el@mpicci		
		w.mpicciri		ct.com
DE	MOLITIC	ON PLAN	IS	
SCALE	E AS NO	TEN	DATE:	07-22-21
DRAW	VN BY: MAP			
CHK'E	MAP		A-(	)50
1	OF 1			

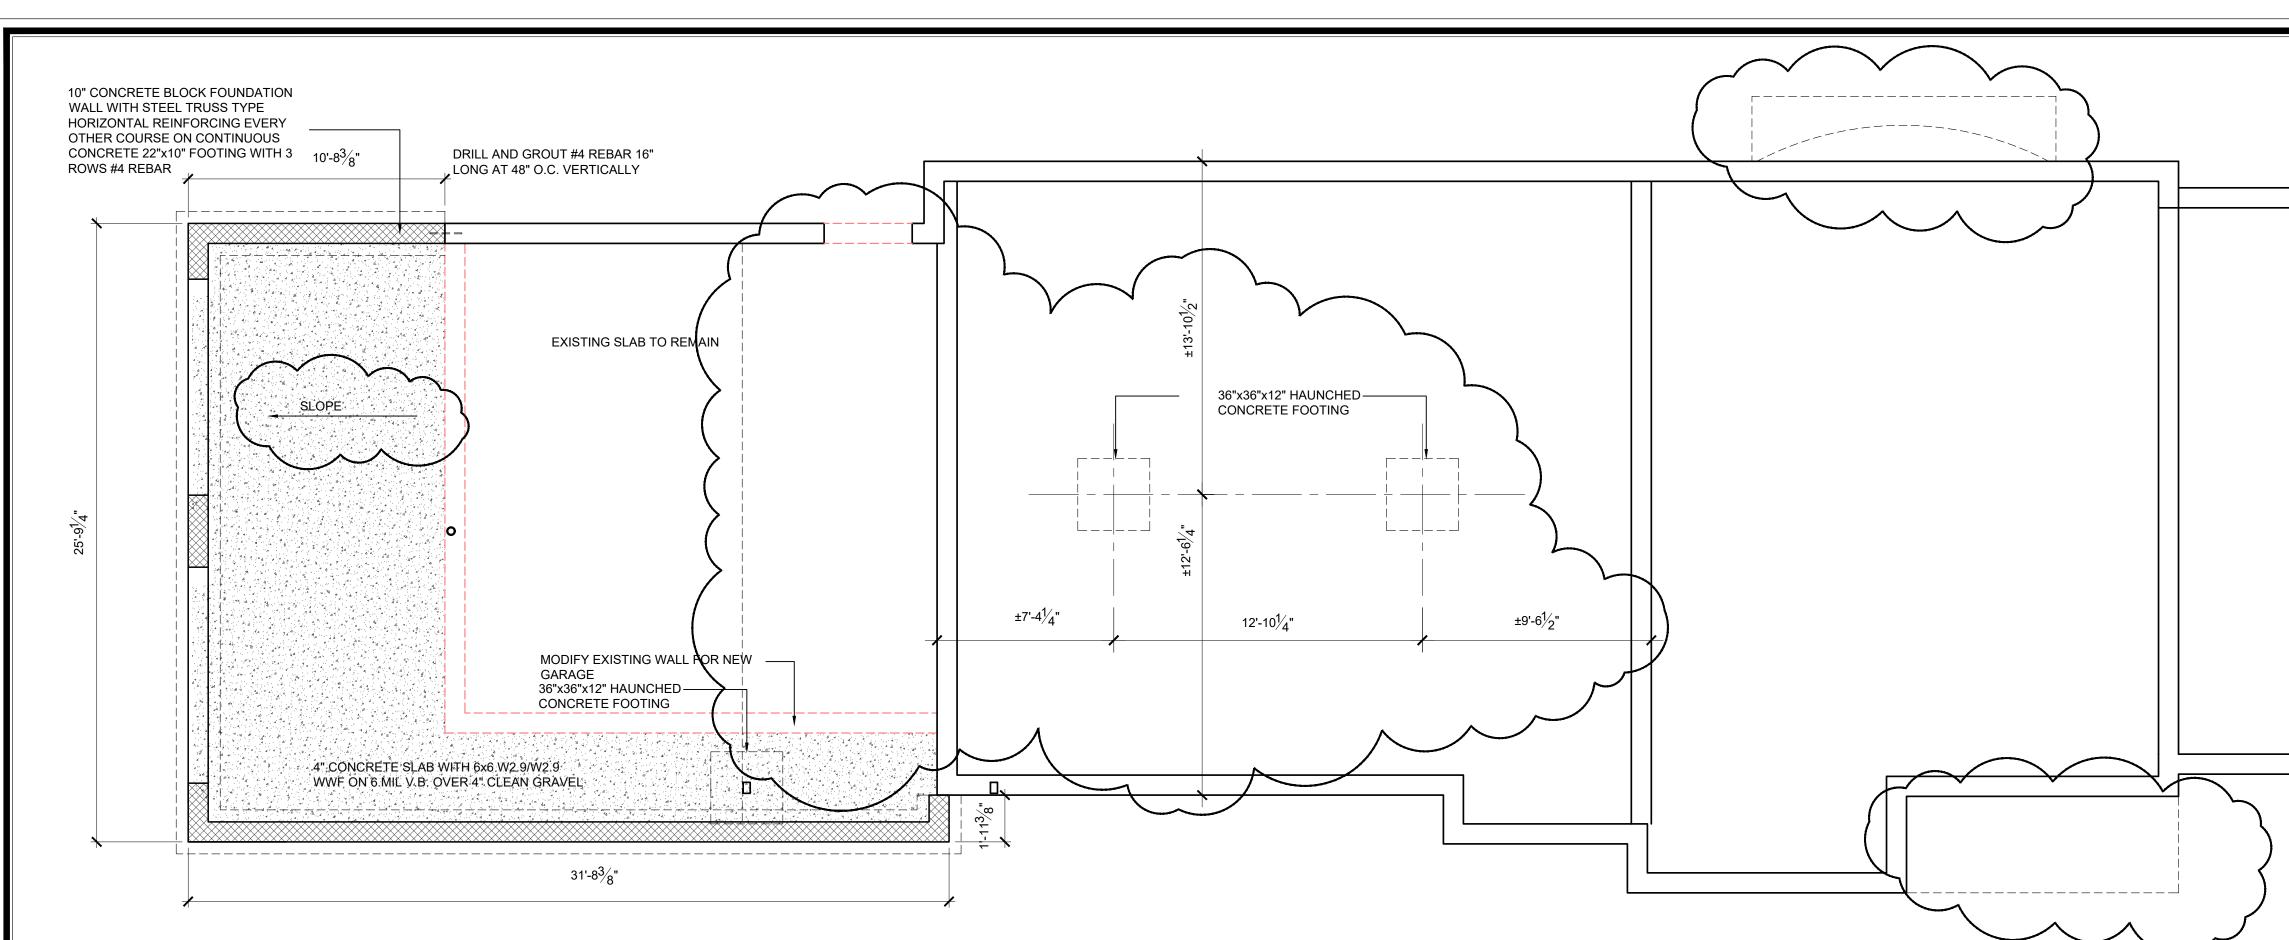

A FIRST FLOOR FOUNDATION PLAN SCALE: 1/4 = 1'-0"

### CONSTRUCTION PLAN NOTES

- PREPARE EXISTING SUBFLOOR FOR NEW FLOOR FINISHES.
   PATCH AND REPAIR ALL WALLS DAMAGED BY DEMOLITION TO APPEAR INTEGRAL WITH NEW WORK.
- PROVIDE SADDLES AND WEATHERSTRIPPING AT ALL EXTERIOR DOORS.
   ALL PARTITIONS WITH WALL HUNG CABINETS, WALL HUNG FIXTURES, WALL TILE OR COAT RACKS TO HAVE 2x WOOD STUDS @ 12" O.C. OR AS REQUIRED.
- SHELVING TO BE PAINT GRADE BIRCH PLYWOOD WITH 1 1/4" HARDWOOD EDGE TYP. IN EVERY CLOSET. PROVIDE ADJUSTABLE SHELVES IN STORAGE OR PROVIDE COAT ROD. BRACKETS AND SHELVING IN EVERY COAT CLOSET.
- 6. ALL PIPING NOT BEING CONNECTED TO ACTIVE FIXTURES SHALL BE CUT BACK BELOW LEVEL OF FINISHED FLOOR AND CAPPED PER APPLICABLE CODES AND REGULATIONS.

### **DIVISION 4 MASONRY**

- GENERAL REQUIREMENTS: G.C. SHALL PROVIDE ALL NECESSARY LABOR, MATERIALS AND EQUIPMENT TO COMPLETE ALL MASONRY SHOWN OR NOTED IN THESE DOCUMENTS. THE GENERAL REQUIREMENTS OF SECTION 1 SHALL APPLY TO ALL WORK UNDER THIS HEADING. A. ALL WORK IN THIS SECTION SHALL COMPLY WITH STATE AND LOCAL
- CODES. B. MATERIALS: ALL MATERIAL SHALL COMPLY WITH THE LATEST A.S.T.M. STANDARDS.
- 1. POROUS FILL (AS REQUIRED) CLEAN GRAVEL OR CRUSHED STONE. NO CINDERS.
- 2. MORTAR 1.3 PORTLAND CEMENT MORTAR FOR ALL CONCRETE BLOCKWORK. 1:6 PORLAND CEMENT - LIME MORTAR FOR STONE WORK.
- NO RETEMPERING PERMITTED. 3. REINFORCING (AS REQUIRED) - DUR-O-WALL TRUSS-TYPE REINFORCING AS NOTED.
- 4. CONCRETE MASONRY UNITS (C.M.U.) (AS REQUIRED) LOAD BEARING STONE CONCRETE - MASONRY UNITS. AS MANUFACTURED BY BEDFORD HILLS CONCRETE PRODUCTS CO. OR APPROVED EQUAL, SIZE AS REQUIRED, AND AS NOTED IN DOCUMENTS.
- C. CONCRETE BLOCKWORK SHALL BE REINFORCED ON EVERY SECOND HORIZONTAL JOINT WITH DUR-O-WALL TRUSS-TYPE BLOCK REINFORCEMENT. LAY BLOCKS WITH CELLS VERTICAL AND JOINTS STAGGERED IN EACH COURSE. ALL BLOCKWORK TO BE PROPERLY
- BONDED TOGETHER AND TO ADJACENT WORK. D. COMPLY WITH RECOMMENDED METHODS AND PRACTICE AS DESCRIBED BY NATIONAL CONCRETE MASONRY ASSOCIATION STANDARDS AND BRICK INSTITUTE OF AMERICA.


### CAST-IN -PLACE CONCRETE


- DO ALL WORK IN CONFORMANCE WITH AMERICAN CONCRETE INSTITUTE STANDARDS. PERFORM ALL WORK IN ACCORDANCE WITH ACI-318 BUILDING CODE REQUIREMENTS FOR REINFORCED CONCRETE AND ACI-301 SPECIFICATIONS FOR STRUCTURAL CONCRETE FOR BUILDINGS, UNLESS SPECIFIED OTHERWISE.
- 2. INSPECTION AND TESTING (INCLUDING BUT NOT LIMITED TO TEST CYLINDERS: TAKE THREE TEST CYLINDERS FROM EACH POUR, LABEL WITH DATE AND LOCATION PLACED, AND DELIVER TO OWNER FOR TESTING) OF CONCRETE WORK AND CONCRETE MIX SHALL BE PERFORMED IN ACCORDANCE OF THE LOCAL BUILDING DEPARTMENT.
- CONTRACTOR SHALL VERIFY DIMENSIONS AND LOCATIONS OF ALL OPENINGS, PIPE SLEEVES, ANCHOR BOLTS, ETC., AS REQUIRED BY ALL TRADES, BEFORE CONCRETE IS PLACED.
   PROVIDE SAND AND GRAVEL BASE.
- 5. WELDED WIRE FABRIC SHALL BE 6" X 6" W2.9/W2.9 SIZE PLAIN FINISH CONFORMING TO ASTM A185 UNLESS OTHERWISE INDICATED. ALL REINFORCING BARS SHALL CONFORM TO ASTM SPEC A615 GRADE 60.
- REINFORCING STEEL SHALL BE BILLET STEEL BARS, GRADE 60, GALVANIZED FINISH, CONFORMING TO ASTM A615. COMPLETE WITH ALL ACCESSORIES SUCH AS CHAIRS, BAR SUPPORTS, SPACERS, TIE WIRE, ETC.
   SCREED AND FINISH CONCRETE SMOOTH AND LEVEL OR SLOPED AS INDICATED TO RECEIVE FURTHER CONSTRUCTION.
- EXTERIOR PAVEMENTS TO HAVE BROOMED FINISH.
   ALL CONCRETE DESIGN AND PLACEMENT SHALL COMPLY WITH THE LATEST EDITION OF THE ACI 301, "SPECIFICATION FOR STRUCTURAL CONCRETE FOR BUILDINGS". HOT WEATHER CONCRETING SHALL BE IN ACCORDANCE WITH ACI 305. COLD WEATHER CONCRETING SHALL BE IN ACCORDANCE WITH ACI 306. ALL OTHER APPLICABLE CODES SHALL ALSO BE
- FOLLOWED.
  9. CONCRETE SHALL BE NORMAL WEIGHT CONCRETE EXCEPT LIGHT WEIGHT CONCRETE SHALL BE USED FOR SLABS ON STEEL DECK UNLESS NOTED OTHERWISE. CONCRETE SHALL DEVELOP A MINIMUM COMPRESSIVE STRENGTH OF 3,500 PSI AT 28 DAYS FOR FOUNDATIONS. SLUMP SHALL NOT EXCEED 4".
- REINFORCEMENT SHALL BE DEFORMED INTERMEDIATE GRADE NEW BILLET STEEL CONFORMING TO ASTM DESIGNATION A-615, GRADE 60. WELDED WIRE FABRIC SHALL CONFORM TO ASTM A-185.
   FOLLOW ACI RULES AS TO TIES, ANCHORAGE, SPLICES, CONCRETE COVERAGE AND REINFORCEMENT SUPPORTS.
- REINFORCEMENT MARKED "CONTINUOUS" (CONT.) SHALL BE LAPPED 36 BAR DIAMETERS AT SPLICES AND CORNERS, AND HOOKED AT NON-CONTINUOUS ENDS OR EXTENDED 36 BAR DIAMETERS UNLESS OTHERWISE NOTED.
   CONSTRUCTION JOINTS SHALL BE LOCATED AT POINTS OF ZERO SHEAR. NO CONSTRUCTION JOINTS SHALL BE LOCATED
- IN MEMBERS CARRYING A CONCENTRATED LOAD. PROVIDE SHEAR BARS AS DIRECTED BY THE ENGINEER. LOCATIONS OF CONSTRUCTION JOINTS SHALL BE ACCEPTED BY THE ENGINEER.
  14. PROVIDE SLEEVES AND BOX OUT FOR OPENINGS FOR MECHANICAL TRADES FOR SIZE AND LOCATION OF ALL OPENINGS.
- 14. PROVIDE SLEEVES AND BOX OUT FOR OPENINGS FOR MECHANICAL TRADES FOR SIZE AND LOCATION OF ALL OPENINGS SEE ARCHITECTURAL AND MECHANICAL DRAWINGS IN ADDITION TO STRUCTURAL DRAWINGS. OPENINGS SHALL BE PLACED SO AS NOT TO AFFECT THE STRENGTH OF THE STRUCTURAL MEMBERS.


## GENERAL NOTES

- A. EXCAVATION AND EARTHWORK
  1. SOILS AT THE BASE OF ALL EXCAVATIONS SHALL HAVE A PRESUMPTIVE BEARING VALUE OF NO LESS THAN 2 TSF.
  2. IF SOILS ARE UNSUITABLE AT THE LEVELS SHOWN ON THE DRAWINGS FOR FOUNDATIONS, THE EXCAVATION SHALL
- BE DEEPENED UNTIL SUITABLE SOILS ARE ENCOUNTERED. 3. SOILS AT THE EXCAVATION LEVEL SHALL BE COMPACTED TO 95% MAX. DENSITY, ASTM D 1557. B. CONCRETE WORK
- ALL CONCRETE SHALL CONFORM TO ACI 318-86 (REV. 1986) BUILDING CODE, AND ACI DESIGN HANDBOOK 340. IR-84.
   CONCRETE: Fc = 3500 PSI
- 3. REINFORCING STEEL: Fy = 60 KSI 4. ALL EXTERIOR CONCRETE REQUIRES AIR ENTRAINMENT.
- 5. CONCRETE SLUMP SHALL BE NO GREATER THAN 4".
- 6. CURING IS REQUIRED PER ACI CODE.
   7. WELDING REINFORCING STEEL IS PROHIBITED.
- WELDING REINFORCING STEEL IS PROHIBITED.
   ANCHOR BOLTS SHALL BE IMBEDDED, OR DRILL-IN, AT THE DISCRETION OF THE CONTRACTOR. ANY EXTERIOR
- ANCHOR BOLTS SHALL BE GALVANIZED. C. FIELD VERIFY ALL EXISTING DIMENSIONS AS INDICATED ON DRAWINGS.
- 1. GENERAL CONTRACTOR TO LAYOUT ROOM WITH EXISTING CONDITIONS AND FIELD VERIFY PRIOR TO INSTALLING INTERIOR WALLS. NOTIFY ARCHITECT OF ANY DISCREPANCIES.


Michael Piccirillo Architecture				
NOTE: DO NOT SCALE DRAWINGS. REFER TO WRITTEN MEASUREMENTS FOR ACCURANCY, OR CONTACT ARCHITECT. CONTACT ARCHITECT IF THERE ARE ANY DISCECPENCIES UNAUTHORIZED ALTERATIONS OR ADDITIONS TO THIS DRAWING IS A VIOLATION OF NEW YORK STATE EDUCATION LAW. © Copyright 2016 MICHAEL PICCIRILLO ARCHITECTURE				
WALL AND DOOR SYMBOLS   EXISTING WALL TO REMAIN   MEW WALLS TO BE CONSTRUCTED. SEE BUILDING SECTION FOR DETAILS   Image: Street Building Section For D				
No.       DATE:       ISSUE:         1       08/31/22       ISSUED FOR CLIENT CHANGES				
VARGHESE RESIDENCE RENOVATION/ADDITION PROJECT ADDRESS: 6 FOX RIDGE ROAD ARMONK, NEW YORK 10504				
MICHAEL A PICCIRILLO, AIA 345 KEAR STREET SUITE #203				
YORKTOWN HEIGHTS, NEW YORK 10598 TELEPHONE: 914-368-9838 FACSIMILE: 914-368-9839 michael@mpiccirilloarchitect.com www.mpiccirilloarchitect.com				
SCALE:         AS NOTED         DATE:         09-11-21           DRAWN BY:         MAP				

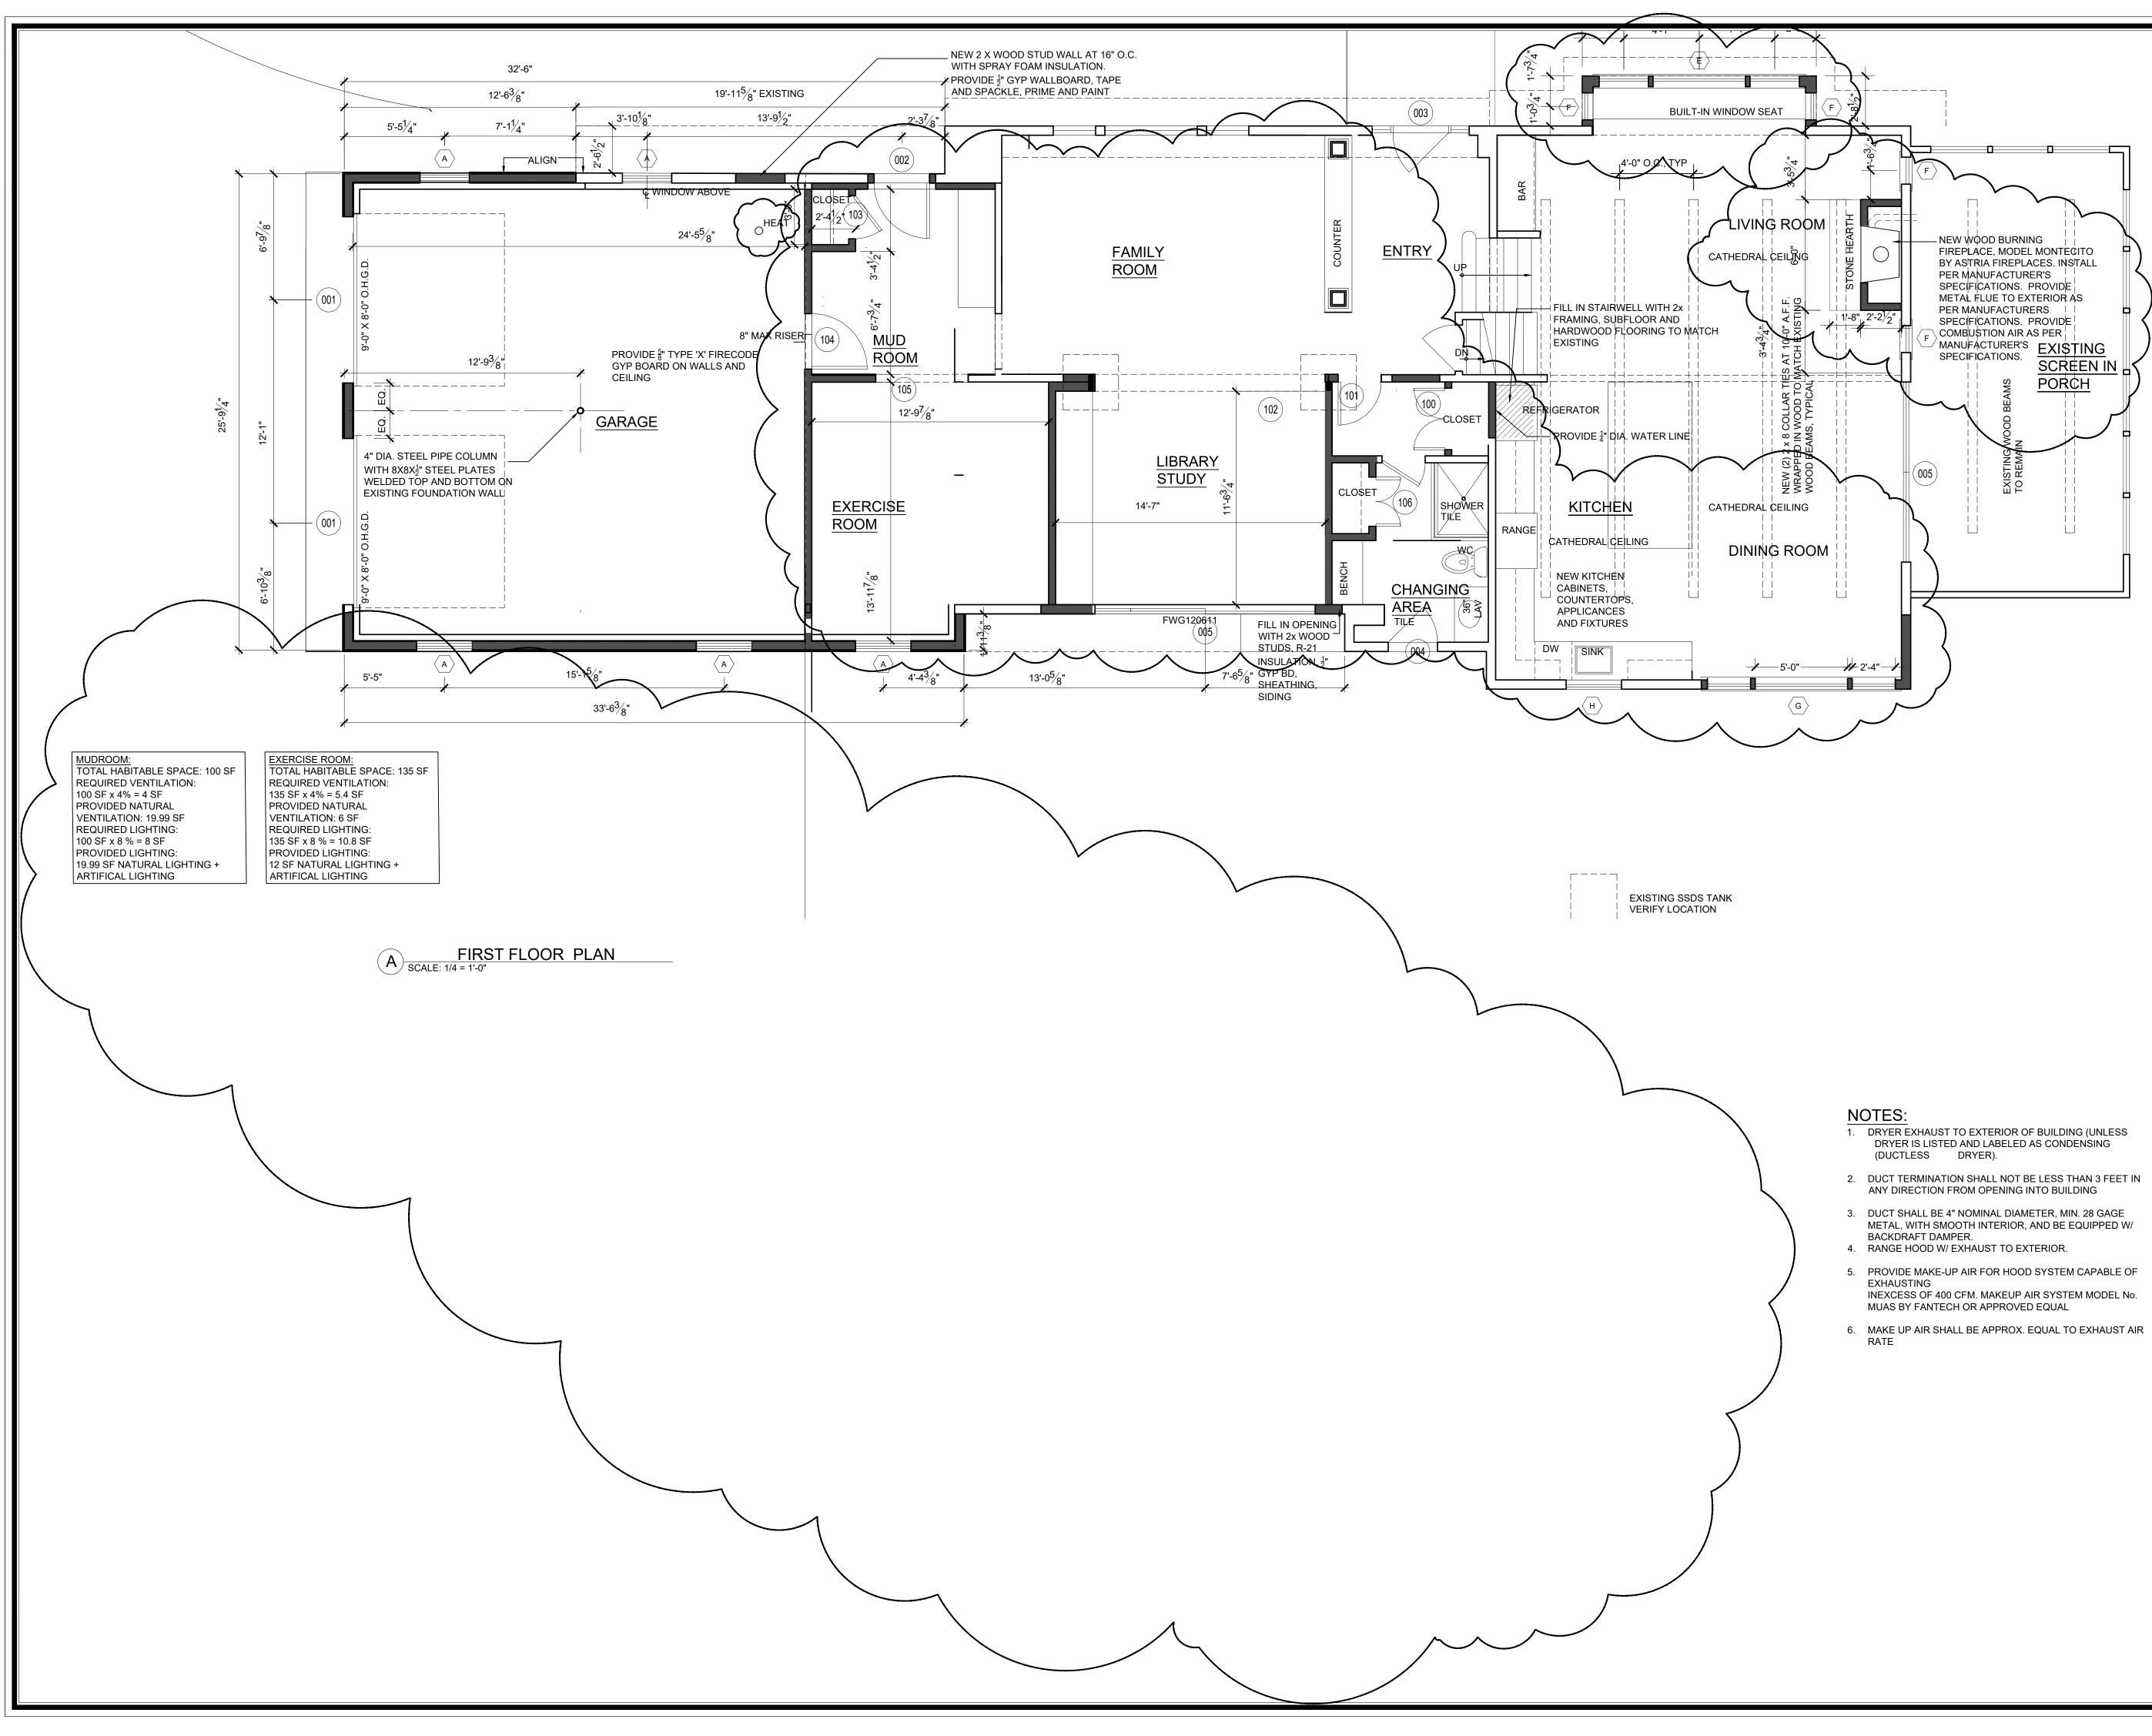

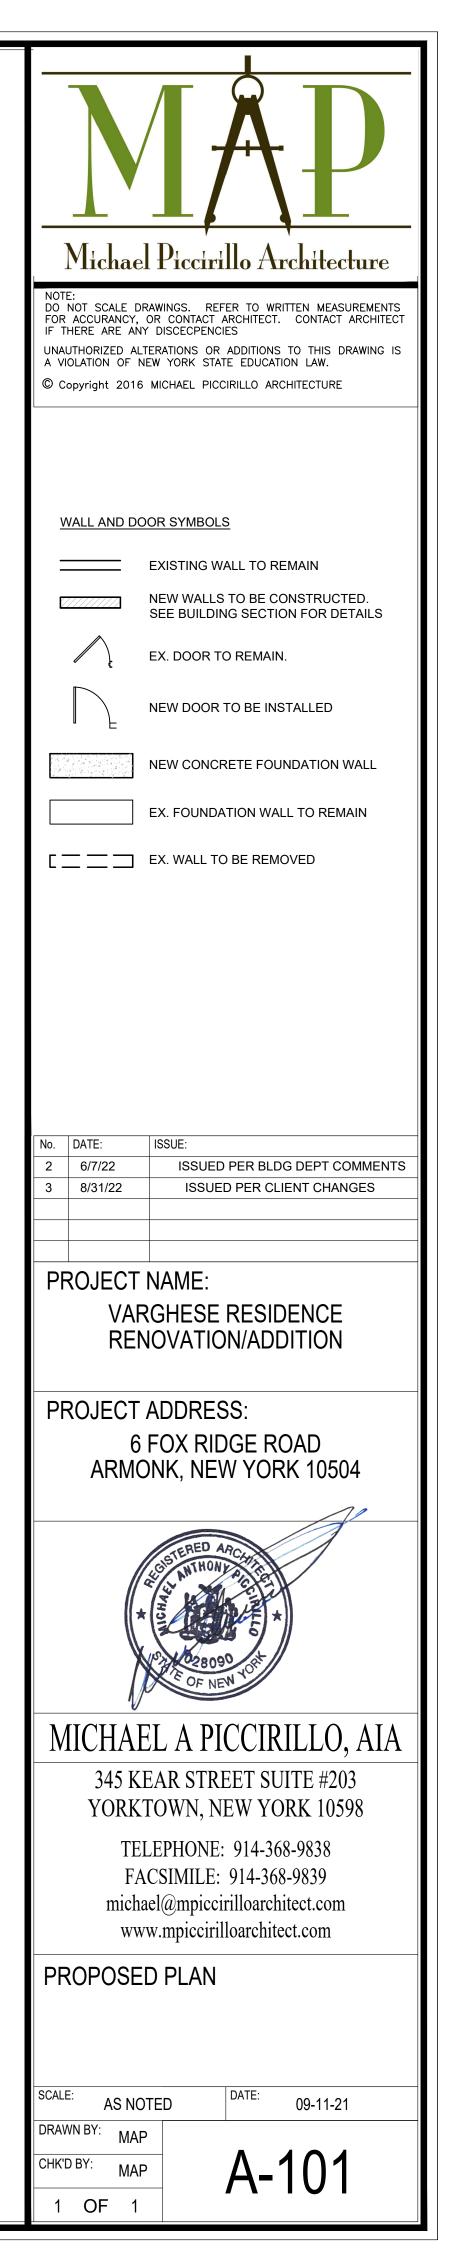

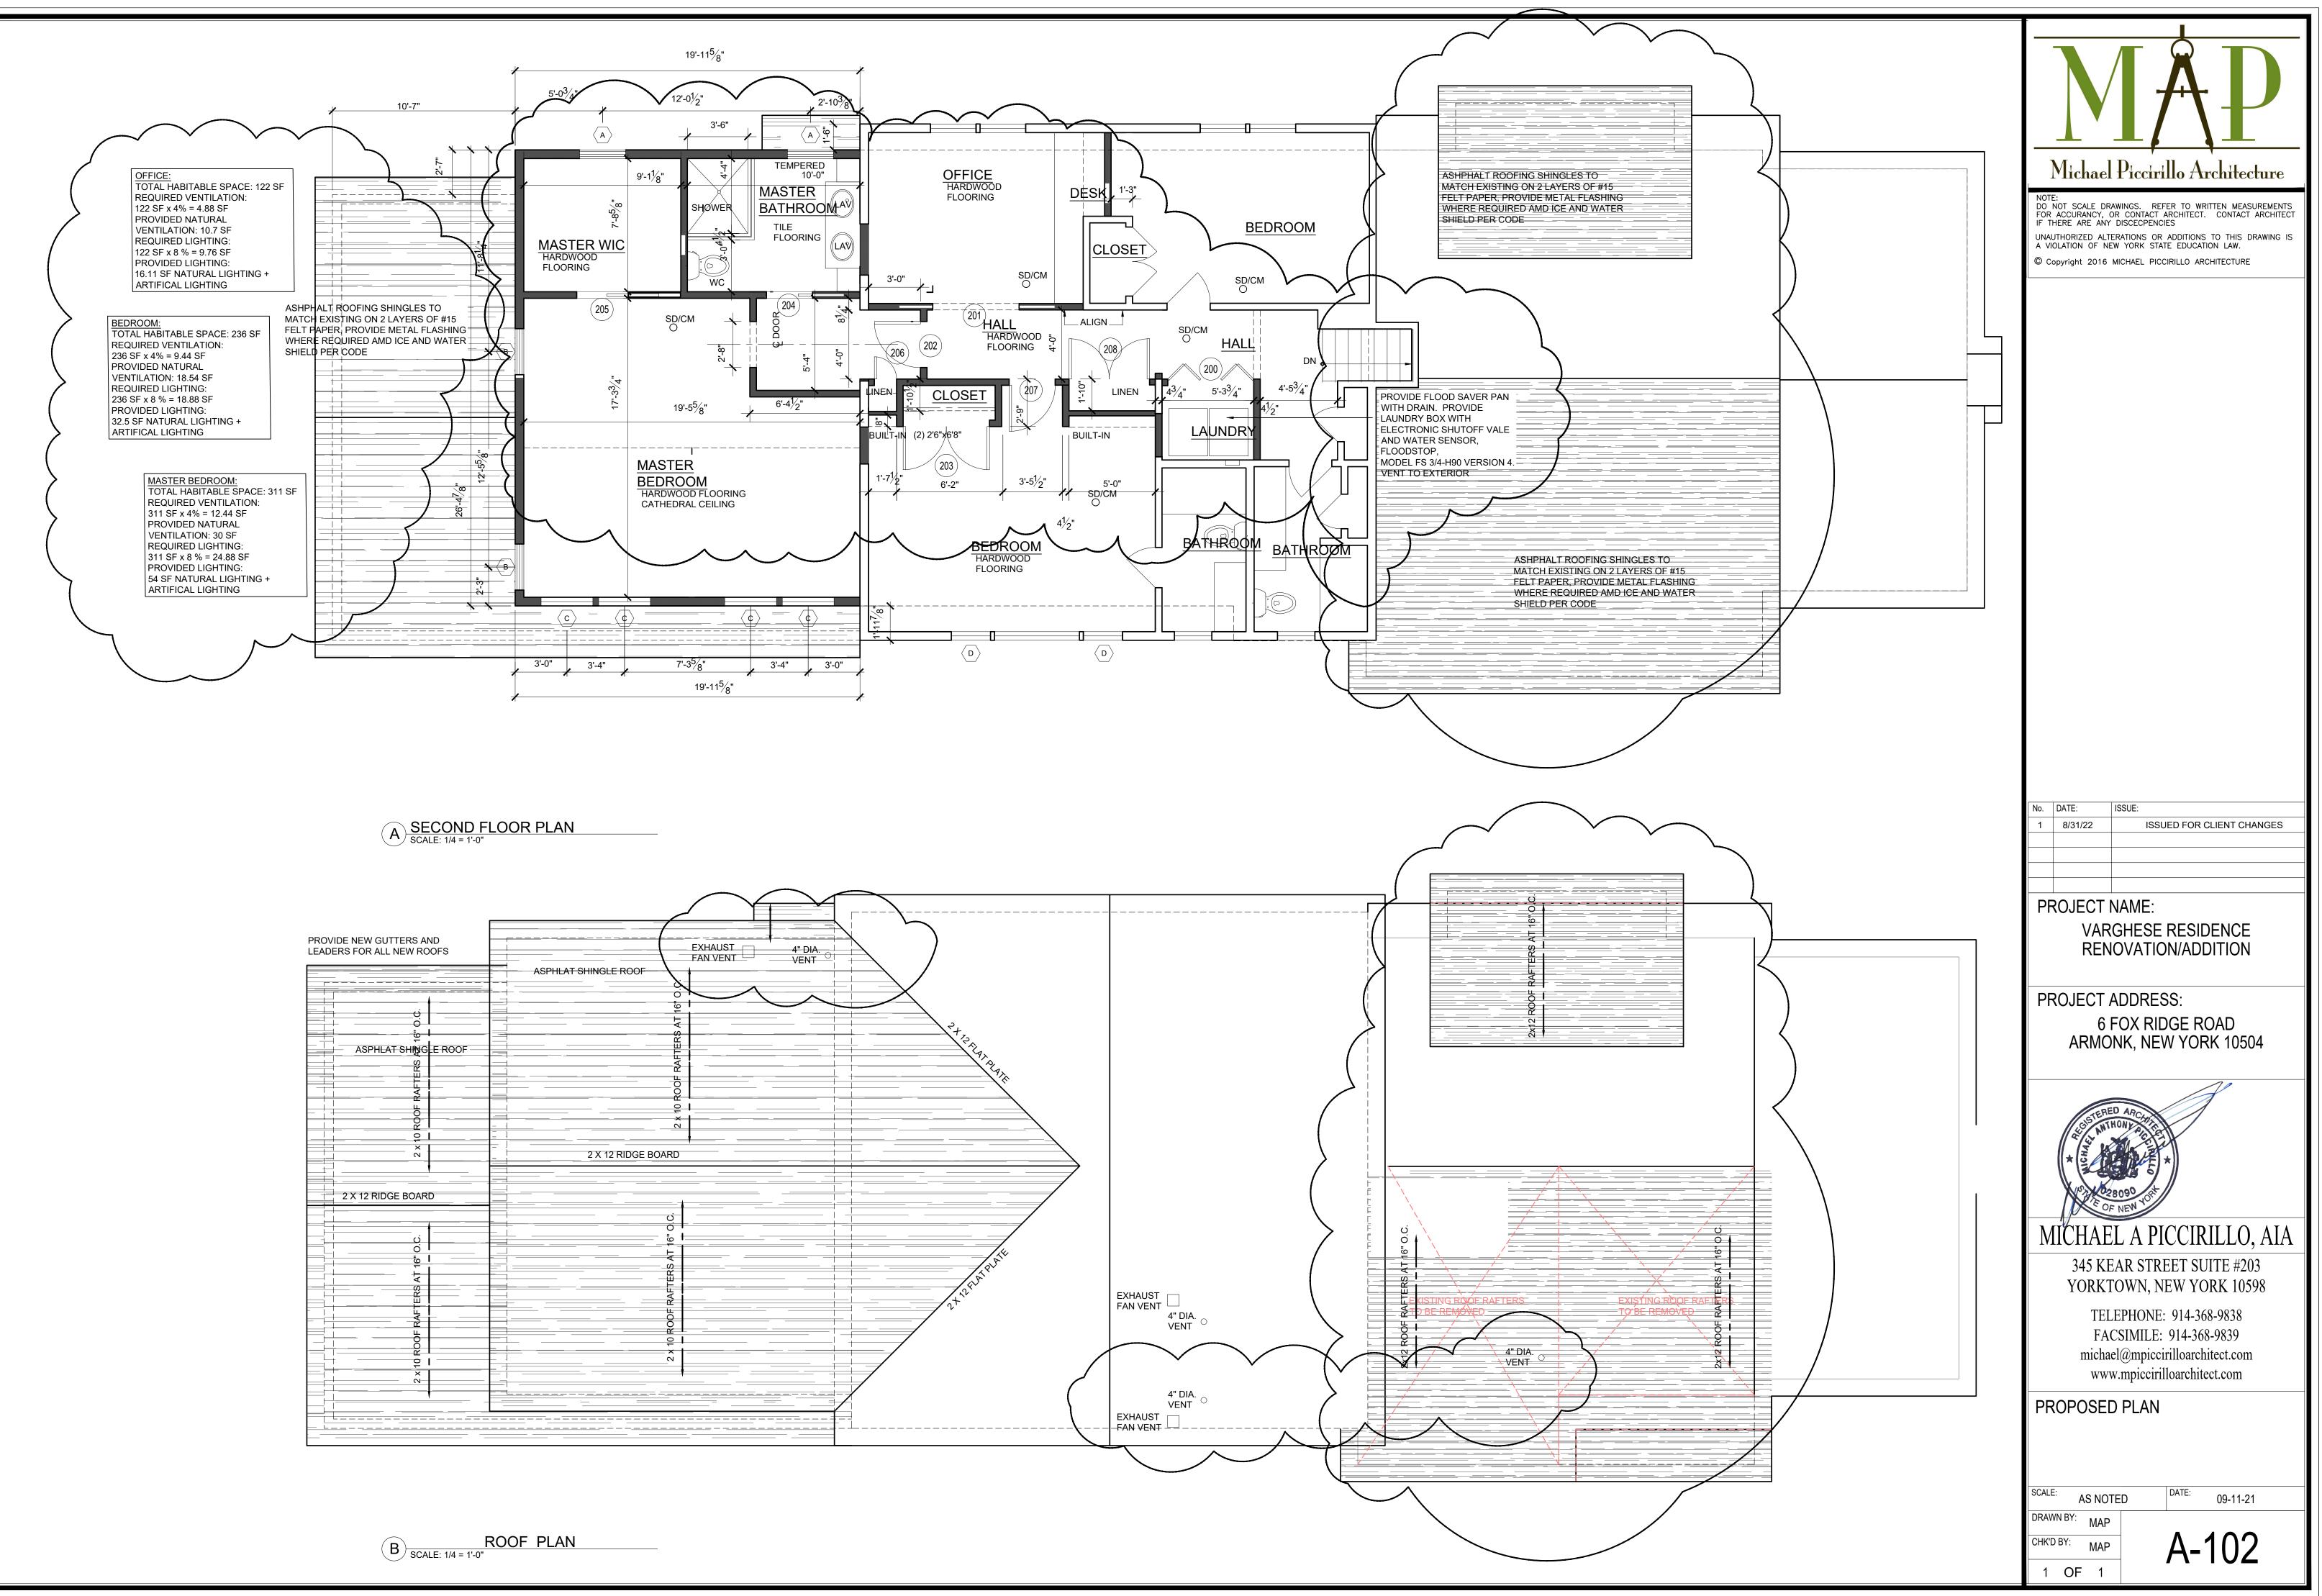

IDE NEW GUTTERS AND ERS FOR ALL NEW ROOFS	EXHAUS FAN VE
	ASPHLAT SHINGLE ROOF
	-+
О=	
	ОО
	<u>6</u>
	≓×∔
6	
<del>_</del>	
N	2 X 12 RIDGE BOARD
2 X 12 RIDGE BOARD	
<u>0</u>	
<u>o</u>	
¥	
	<u></u>
il E	
₹;	
К 	
  	N
10 10 10 10 10	

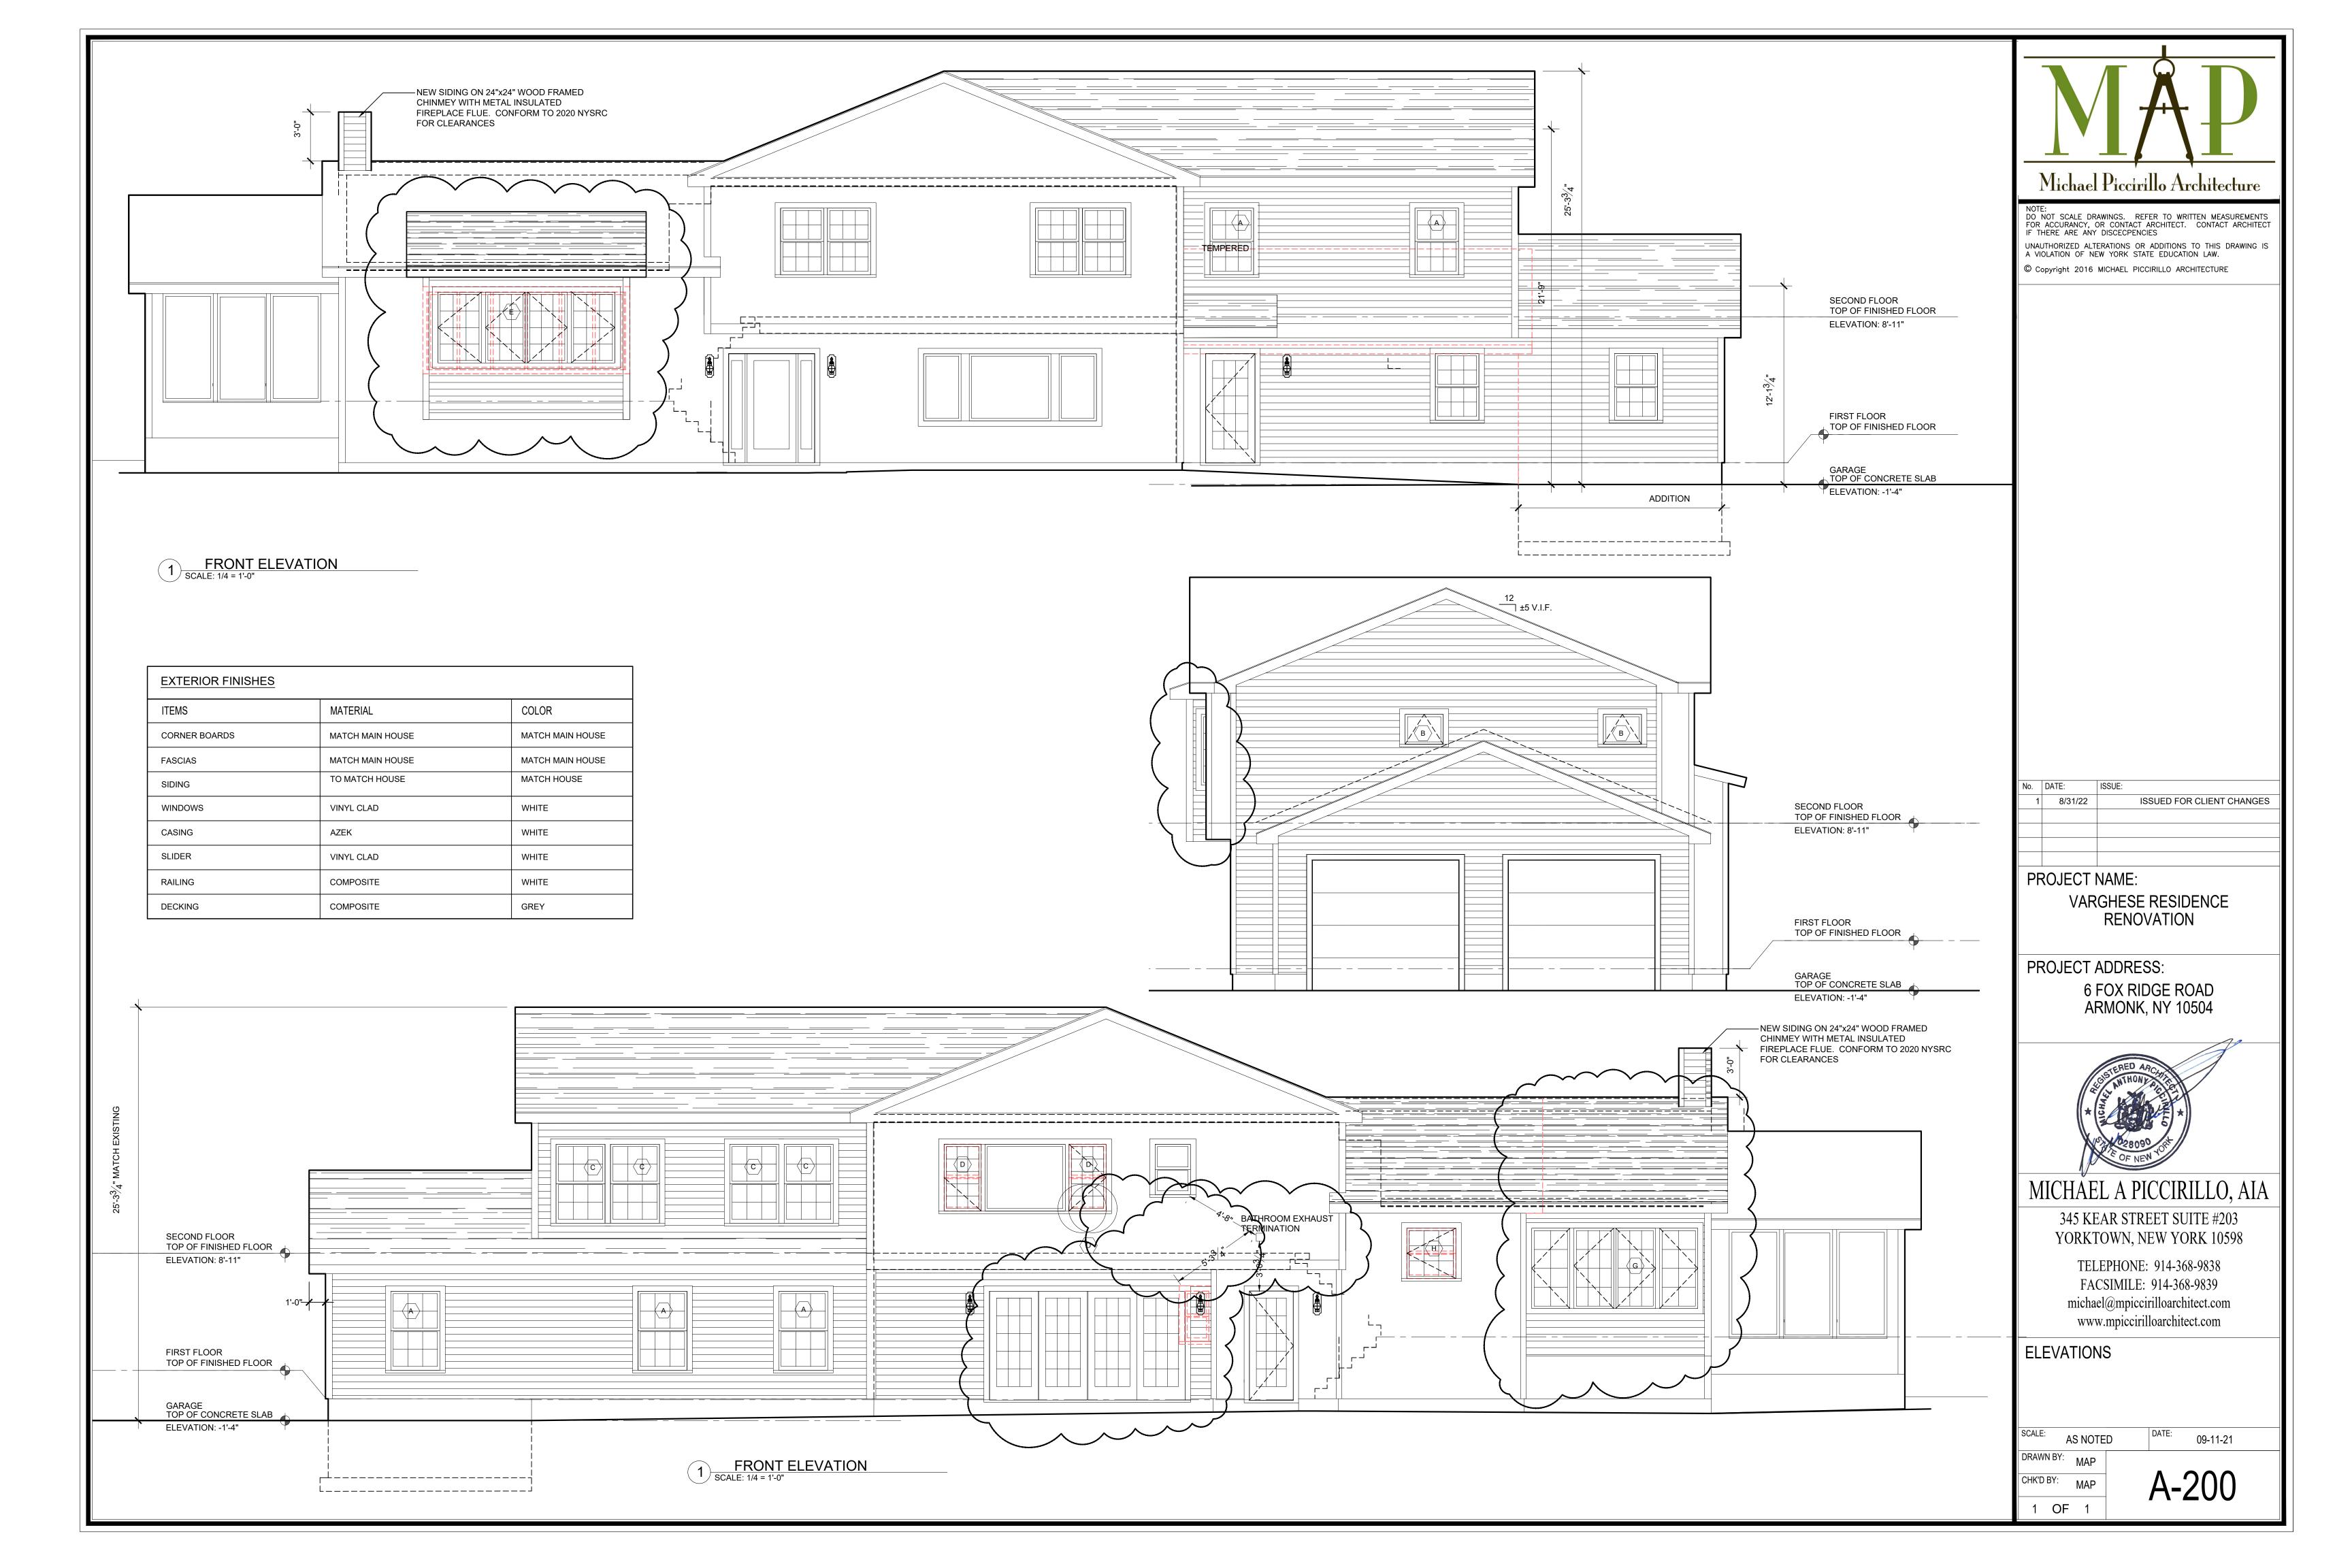

/INDOW	MODEL	WINDOW ROUGH OPENING						
ARK	NUM.	(Width x Height)	WINDOW TYPE	INTERIOR CASING	EXTERIOR CASING	MUNTIN PATT	ERN HARDWARE	REMARKS
4	TW2640	$2'-8\frac{1}{4}" \times 4'-4\frac{1}{8}"$	DOUBLE HUNG	MATCH EXISTING	MATCH EXISTING	SEE ELEVATIO	N MATCH EXISTI	NG BUG SCREEN
3	A251	2'-4 7/8" x 2'-0 5/8"	AWNING	MATCH EXISTING	VINYL MATCH EXISTING	SEE ELEVATIO	N MATCH EXISTI	NG BUG SCREEN
C	I4/216410	3'-0 1/ <del>8" x 3 -0</del> 7/8"	DOUBLE HUNG	MATCH EXISTING	VINYL MATCH EXISTING	SEE ELEVATIO	N MATCH EXISTI	ING BUG SCREEN
$\sim$	NEW EGRESS WINDC	W ± 2'-3" × 4'-3" V.I.F.	CASEMENT	MATCH EXISTING	VINYL MATCH EXISTING	SEE ELEVATIO	N MATCH EXISTI 90° EGRESS HARI	
Ξ	CX145	2'-8" x 4'-5 3/8"	CASEMENT	MATCH EXISTING	VINYL	SEE ELEVATIO		
	CW245	4'-9" x 4'-5 3/8" 2'-8" x 4'-5 3/8"	CASEMENT CASEMENT		MATCH EXISTING			
	CX145	2-8 x 4-5 3/8		MATCH EXISTING	VINYL	SEE ELEVATIO	N MATCH EXISTI	NG BUG SCREEN
=	CR145	1'-5 1/2" x 4'-5 3/8"	CASEMENT		MATCH EXISTING			
G	CW15	2'-4" x 5'-0 3/8"	CASEMENT	MATCH EXISTING	VINYL MATCH EXISTING	SEE ELEVATIO	N MATCH EXISTI	NG BUG SCREEN
	CW25 CW15	4'-9" x 5'-0 3/8" 2'-4" x 5'-0 3/8"	CASEMENT CASEMENT					
Н	CXW13	3'-0 1/2" x 3'-0 1/2"	CASEMENT	MATCH EXISTING	VINYL MATCH EXISTING	SEE ELEVATION	N MATCH EXISTIN	NG BUG SCREEN
$\smile$	$\sim$		$\sim$	$\sim$				
	SPECIFICATION HOP DRAWINGS MUST	BE SUBMITTED TO THE ARCHITECT.				DOOR SCHEDULE	<u>ENOTES</u>	
ALL WI	NDOWS SCHEDULED A	RE MANUFACTURED BY ANDERSEN WIN	DOW COMPANY.				OVIDE ALL DOOR LATCH/ TO INSTALL ALL HINGES/	
INTERIO		WHITE INTERIOR (MATCH EXISTING)					HER-STRIPPING IS CALLE	
SPACE								
	G: INSULATED LOW	E 272 GLASS WITH ARGON GAS,						
		CH EXISTING HERE REQUIRED BY THE 2020 RESIDENT	IAL CODE OF NEW YORK	STATE.				
DOOF	RSCHEDULE							
OOR IUMBER		MODEL NUMBER DOOR OPENING (W x H xTHICKNESS		DOOR MATE	DOOR & FRAME RIAL FINISH		HARDWARE SET	REMARKS
001	GARAGE	T.B.D. \$3,000 ALLOWANCE PER DO 9'-0" x 8'-0" x 1 <sup>3</sup> / <sub>4</sub> "	OR SELF CLOSING INSULATED OVERHE GARAGE DOOR	AD WOOD / GLASS	s wood		ENTRY LOCKSET WEATHER-STRIPPING	3/4 HP MOTOR,
002						WOOD	WEATHER-STRIPPING	KEYPADS, REMOTE
	MUDROOM	T.B.D.		WOOD / GLASS			ENTRY LOCKSET	
	MUDROOM	3'-0" x 6'-8" x 1 <sup>3</sup> / <sub>4</sub> "	ENTRY	WOOD / GLAS	S WOOD			KEYPADS, REMOTE
003	ENTRY	3'-0" x 6'-8" x 1 <sup>3</sup> 4" EXISTING	ENTRY	WOOD / GLAS			ENTRY LOCKSET	KEYPADS, REMOTE
003 004		3'-0" x 6'-8" x 1 <sup>3</sup> / <sub>4</sub> "		WOOD / GLASS		WOOD	ENTRY LOCKSET WEATHER-STRIPPING	KEYPADS, REMOTE
	ENTRY	3'-0" x 6'-8" x 1 <sup>3</sup> 4" EXISTING	ENTRY	WOOD / GLASS	WOOD	WOOD	ENTRY LOCKSET	KEYPADS, REMOTE
004		3'-0" x 6'-8" x 1 <sup>3</sup> / <sub>4</sub> " EXISTING EXISTING FWG 120611 12'-0" x 6'-11" FWG 100611			WOOD S WOOD	WOOD WOOD	ENTRY LOCKSET WEATHER-STRIPPING	KEYPADS, REMOTE
004 005 006	ENTRY LAUNDRY FAMILY ROOM DINING ROOM	3'-0" x 6'-8" x 1 $\frac{3}{4}$ " EXISTING EXISTING FWG 120611 12'-0" x 6'-11" FWG 100611 9'-9 3/4" x 6'-11" 4 PANEL	ENTRY ENTRY QUAD GLIDER QUAD GLIDER	WOOD / GLASS WOOD / GLASS	WOOD S WOOD	WOOD WOOD WOOD	ENTRY LOCKSET WEATHER-STRIPPING ENTRY LOCKSET WEATHER-STRIPPING ENTRY LOCKSET WEATHER-STRIPPING	KEYPADS, REMOTE ALUMINUM SILL ALUMINUM SILL
004	ENTRY LAUNDRY FAMILY ROOM DINING ROOM CLOSET	3'-0" x 6'-8" x $1\frac{3}{4}$ " EXISTING EXISTING FWG 120611 12'-0" x 6'-11" FWG 100611 9'-9 3/4" x 6'-11" 4 PANEL (2)1'-8" x 6'-8" x $1\frac{3}{4}$ "	ENTRY ENTRY QUAD GLIDER QUAD GLIDER DOUBLE	WOOD / GLASS WOOD / GLASS MDF	WOOD S PAINT	WOOD WOOD WOOD WOOD	ENTRY LOCKSET WEATHER-STRIPPING ENTRY LOCKSET WEATHER-STRIPPING ENTRY LOCKSET WEATHER-STRIPPING PASSAGE	KEYPADS, REMOTE ALUMINUM SILL ALUMINUM SILL ALUMINUM SILL
004	ENTRY LAUNDRY FAMILY ROOM DINING ROOM	3'-0" x 6'-8" x $1\frac{3}{4}$ " EXISTING EXISTING FWG 120611 12'-0" x 6'-11" FWG 100611 9'-9 3/4" x 6'-11" 4 PANEL (2)1'-8" x 6'-8" x $1\frac{3}{4}$ " 6 PANEL 2'-4" x 6'-8" x $1\frac{3}{4}$ "	ENTRY ENTRY QUAD GLIDER QUAD GLIDER	WOOD / GLASS WOOD / GLASS	WOOD S WOOD	WOOD WOOD WOOD WOOD	ENTRY LOCKSET WEATHER-STRIPPING ENTRY LOCKSET WEATHER-STRIPPING ENTRY LOCKSET WEATHER-STRIPPING	KEYPADS, REMOTE ALUMINUM SILL ALUMINUM SILL
004 005 006 100	ENTRY LAUNDRY FAMILY ROOM DINING ROOM CLOSET	3'-0" x 6'-8" x $1\frac{3}{4}$ " EXISTING EXISTING FWG 120611 12'-0" x 6'-11" FWG 100611 9'-9 3/4" x 6'-11" 4 PANEL (2)1'-8" x 6'-8" x $1\frac{3}{4}$ " 6 PANEL	ENTRY ENTRY QUAD GLIDER QUAD GLIDER DOUBLE	WOOD / GLASS WOOD / GLASS MDF MDF	WOOD S PAINT	WOOD WOOD WOOD WOOD	ENTRY LOCKSET WEATHER-STRIPPING ENTRY LOCKSET WEATHER-STRIPPING ENTRY LOCKSET WEATHER-STRIPPING PASSAGE	KEYPADS, REMOTE ALUMINUM SILL ALUMINUM SILL ALUMINUM SILL
004 005 006 100 101	ENTRY LAUNDRY FAMILY ROOM DINING ROOM CLOSET BATHROOM	3'-0" x 6'-8" x $1\frac{3}{4}$ " EXISTING EXISTING FWG 120611 12'-0" x 6'-11" FWG 100611 9'-9 3/4" x 6'-11" 4 PANEL (2)1'-8" x 6'-8" x $1\frac{3}{4}$ " 6 PANEL 2'-4" x 6'-8" x $1\frac{3}{4}$ "	ENTRY ENTRY QUAD GLIDER QUAD GLIDER DOUBLE SINGLE	WOOD / GLASS WOOD / GLASS MDF MDF	WOOD S WOOD S WOOD PAINT PAINT	WOOD WOOD WOOD WOOD WOOD WOOD WOOD	ENTRY LOCKSET WEATHER-STRIPPING ENTRY LOCKSET WEATHER-STRIPPING ENTRY LOCKSET WEATHER-STRIPPING PASSAGE BATHROOM LOCKSET DUMMY KNOBS	KEYPADS, REMOTE ALUMINUM SILL ALUMINUM SILL ALUMINUM SILL
004 005 006 100 101 102	ENTRY LAUNDRY FAMILY ROOM DINING ROOM CLOSET BATHROOM STUDY	3'-0" x 6'-8" x $1\frac{3}{4}$ " EXISTING EXISTING FWG 120611 12'-0" x 6'-11" FWG 100611 9'-9 3/4" x 6'-11" 4 PANEL (2)1'-8" x 6'-8" x $1\frac{3}{4}$ " 6 PANEL 2'-4" x 6'-8" x $1\frac{3}{4}$ " 12'-6" x 6'-8" 4 PANEL 2'-4" x 6'-8" x $1\frac{3}{4}$ " 6 PANEL 2'-4" x 6'-8" x $1\frac{3}{4}$ "	ENTRY ENTRY QUAD GLIDER QUAD GLIDER DOUBLE SINGLE TRIMMED OPENIN	WOOD / GLASS WOOD / GLASS MDF MDF IG MDF	WOOD S WOOD S PAINT PAINT PAINT	WOOD WOOD WOOD WOOD WOOD WOOD WOOD WOOD	ENTRY LOCKSET WEATHER-STRIPPING ENTRY LOCKSET WEATHER-STRIPPING ENTRY LOCKSET WEATHER-STRIPPING PASSAGE BATHROOM LOCKSET DUMMY KNOBS BALL CATCHES ENTRY WITH MORTISE,	KEYPADS, REMOTE ALUMINUM SILL ALUMINUM SILL ALUMINUM SILL MARBLE SADDLE C LABEL FIRE RATED
004 005 006 100 101 102 103 104	ENTRY LAUNDRY FAMILY ROOM DINING ROOM CLOSET BATHROOM STUDY CLOSET MUDROOM	3'-0" x 6'-8" x 1 $\frac{3}{4}$ " EXISTING EXISTING FWG 120611 12'-0" x 6'-11" FWG 100611 9'-9 3/4" x 6'-11" 4 PANEL (2)1'-8" x 6'-8" x 1 $\frac{3}{4}$ " 6 PANEL 2'-4" x 6'-8" x 1 $\frac{3}{4}$ " 12'-6" x 6'-8" 4 PANEL 2'-4" x 6'-8" x 1 $\frac{3}{4}$ " 6 PANEL 2'-4" x 6'-8" x 1 $\frac{3}{4}$ "	ENTRY ENTRY QUAD GLIDER QUAD GLIDER DOUBLE SINGLE SINGLE SINGLE SINGLE	WOOD / GLASS WOOD / GLASS MDF IG MDF IG MDF MDF	WOOD S WOOD S WOOD PAINT PAINT PAINT PAINT PAINT	WOOD WOOD WOOD WOOD WOOD WOOD WOOD WOOD	ENTRY LOCKSET WEATHER-STRIPPING ENTRY LOCKSET WEATHER-STRIPPING ENTRY LOCKSET WEATHER-STRIPPING PASSAGE BATHROOM LOCKSET DUMMY KNOBS BALL CATCHES	KEYPADS, REMOTE ALUMINUM SILL ALUMINUM SILL ALUMINUM SILL MARBLE SADDLE
004 005 006 100 101 102 103 104 105	ENTRY LAUNDRY FAMILY ROOM DINING ROOM CLOSET BATHROOM STUDY CLOSET	3'-0" x 6'-8" x $1\frac{3}{4}$ " EXISTING EXISTING FWG 120611 12'-0" x 6'-11" FWG 100611 9'-9 3/4" x 6'-11" 4 PANEL (2)1'-8" x 6'-8" x $1\frac{3}{4}$ " 6 PANEL 2'-4" x 6'-8" x $1\frac{3}{4}$ " 12'-6" x 6'-8" 4 PANEL 2'-4" x 6'-8" x $1\frac{3}{4}$ " 6 PANEL 2'-4" x 6'-8" x $1\frac{3}{4}$ " 5'-0" x 6'-8"	ENTRY ENTRY QUAD GLIDER QUAD GLIDER DOUBLE SINGLE SINGLE SINGLE SINGLE TRIMMED OPENIN	WOOD / GLASS WOOD / GLASS MDF MDF IG MDF IG MDF IG T.B.D.	WOOD SWOOD SWOOD PAINT PAINT PAINT PAINT PAINT PAINT PAINT	WOOD WOOD WOOD WOOD WOOD WOOD WOOD WOOD	ENTRY LOCKSET WEATHER-STRIPPING ENTRY LOCKSET WEATHER-STRIPPING ENTRY LOCKSET WEATHER-STRIPPING PASSAGE BATHROOM LOCKSET DUMMY KNOBS BALL CATCHES ENTRY WITH MORTISE,	KEYPADS, REMOTE ALUMINUM SILL ALUMINUM SILL ALUMINUM SILL MARBLE SADDLE C LABEL FIRE RATED
004 005 006 100 101 102 103 104	ENTRY LAUNDRY FAMILY ROOM DINING ROOM CLOSET BATHROOM STUDY CLOSET MUDROOM	3'-0" x 6'-8" x 1 $\frac{3}{4}$ " EXISTING EXISTING FWG 120611 12'-0" x 6'-11" FWG 100611 9'-9 3/4" x 6'-11" 4 PANEL (2)1'-8" x 6'-8" x 1 $\frac{3}{4}$ " 6 PANEL 2'-4" x 6'-8" x 1 $\frac{3}{4}$ " 12'-6" x 6'-8" 4 PANEL 2'-4" x 6'-8" x 1 $\frac{3}{4}$ " 6 PANEL 2'-4" x 6'-8" x 1 $\frac{3}{4}$ "	ENTRY ENTRY QUAD GLIDER QUAD GLIDER DOUBLE SINGLE SINGLE SINGLE SINGLE	WOOD / GLASS WOOD / GLASS MDF IG MDF IG MDF MDF	WOOD S WOOD S WOOD PAINT PAINT PAINT PAINT PAINT	WOOD WOOD WOOD WOOD WOOD WOOD WOOD WOOD	ENTRY LOCKSET WEATHER-STRIPPING ENTRY LOCKSET WEATHER-STRIPPING ENTRY LOCKSET WEATHER-STRIPPING PASSAGE BATHROOM LOCKSET DUMMY KNOBS BALL CATCHES ENTRY WITH MORTISE,	KEYPADS, REMOTE ALUMINUM SILL ALUMINUM SILL ALUMINUM SILL MARBLE SADDLE C LABEL FIRE RATED
004 005 006 100 101 102 103 104 105	ENTRY LAUNDRY FAMILY ROOM DINING ROOM CLOSET BATHROOM STUDY CLOSET MUDROOM MUDROOM	3'-0" x 6'-8" x $1\frac{3}{4}$ " EXISTING EXISTING FWG 120611 12'-0" x 6'-11" FWG 100611 9'-9 3/4" x 6'-11" 4 PANEL (2)1'-8" x 6'-8" x $1\frac{3}{4}$ " 6 PANEL 2'-4" x 6'-8" x $1\frac{3}{4}$ " 12'-6" x 6'-8" 4 PANEL 2'-4" x 6'-8" x $1\frac{3}{4}$ " 6 PANEL 3'-0" x 6'-8" x $1\frac{3}{4}$ " 5'-0" x 6'-8" T.B.D. BY OWNER	ENTRY ENTRY QUAD GLIDER QUAD GLIDER DOUBLE SINGLE SINGLE SINGLE SINGLE TRIMMED OPENIN	WOOD / GLASS WOOD / GLASS MDF MDF IG MDF IG MDF IG T.B.D.	WOOD SWOOD SWOOD PAINT PAINT PAINT PAINT PAINT PAINT PAINT	WOOD WOOD WOOD WOOD WOOD WOOD WOOD WOOD	ENTRY LOCKSET WEATHER-STRIPPING ENTRY LOCKSET WEATHER-STRIPPING ENTRY LOCKSET WEATHER-STRIPPING PASSAGE BATHROOM LOCKSET DUMMY KNOBS BALL CATCHES ENTRY WITH MORTISE,	KEYPADS, REMOTE ALUMINUM SILL ALUMINUM SILL ALUMINUM SILL MARBLE SADDLE C LABEL FIRE RATED
004 005 006 100 101 102 103 104 105 106	ENTRY LAUNDRY FAMILY ROOM DINING ROOM CLOSET BATHROOM STUDY CLOSET MUDROOM MUDROOM CHANGING RM	3'-0" x 6'-8" x $1\frac{3}{4}$ " EXISTING EXISTING FWG 120611 12'-0" x 6'-11" FWG 100611 9'-9 3/4" x 6'-11" 4 PANEL (2)1'-8" x 6'-8" x $1\frac{3}{4}$ " 6 PANEL 2'-4" x 6'-8" x $1\frac{3}{4}$ " 12'-6" x 6'-8" 4 PANEL 2'-4" x 6'-8" x $1\frac{3}{4}$ " 6 PANEL 3'-0" x 6'-8" x $1\frac{3}{4}$ " 5'-0" x 6'-8" T.B.D. BY OWNER 3'-0" x 6'-8" x $1\frac{3}{4}$ "	ENTRY ENTRY QUAD GLIDER QUAD GLIDER QUAD GLIDER DOUBLE SINGLE TRIMMED OPENIN SINGLE SINGLE TRIMMED OPENIN BARN	WOOD / GLASS WOOD / GLASS MDF MDF IG MDF IG MDF IG MDF IG T.B.D. IG T.B.D.	WOOD SWOOD SWOOD SWOOD PAINT PAINT PAINT PAINT PAINT PAINT PAINT PAINT	WOOD WOOD WOOD WOOD WOOD WOOD WOOD WOOD	ENTRY LOCKSET WEATHER-STRIPPING ENTRY LOCKSET WEATHER-STRIPPING ENTRY LOCKSET WEATHER-STRIPPING PASSAGE BATHROOM LOCKSET DUMMY KNOBS BALL CATCHES ENTRY WITH MORTISE, SELF CLOSING HINGES	KEYPADS, REMOTE ALUMINUM SILL ALUMINUM SILL ALUMINUM SILL ALUMINUM SILL CLABEL FIRE RATED AND FRAME
004 005 006 100 101 102 103 104 105 106 200 201	ENTRY ENTRY ENTRY ENTRY EAUNDRY FAMILY ROOM DINING ROOM CLOSET BATHROOM CLOSET MUDROOM CHANGING RM LAUNDRY HALL MASTER	3'-0" x 6'-8" x 1 $\frac{3}{4}$ " EXISTING EXISTING FWG 120611 12'-0" x 6'-11" FWG 100611 9'-9 3/4" x 6'-11" 4 PANEL (2)1'-8" x 6'-8" x 1 $\frac{3}{4}$ " 6 PANEL 2'-4" x 6'-8" x 1 $\frac{3}{4}$ " 12'-6" x 6'-8" 4 PANEL 2'-4" x 6'-8" x 1 $\frac{3}{4}$ " 6 PANEL 3'-0" x 6'-8" x 1 $\frac{3}{4}$ " 5'-0" x 6'-8" x 1 $\frac{3}{4}$ "	ENTRY ENTRY QUAD GLIDER QUAD GLIDER QUAD GLIDER DOUBLE SINGLE TRIMMED OPENIN SINGLE SINGLE TRIMMED OPENIN BARN BI-FOLD TRIMMED OPENIN	WOOD / GLASS WOOD / GLASS MDF MDF IG MDF IG MDF IG MDF IG T.B.D. IG T.B.D.	WOOD WOOD WOOD WOOD WOOD WOOD WOOD WOOD	WOOD WOOD WOOD WOOD WOOD WOOD WOOD WOOD	ENTRY LOCKSET WEATHER-STRIPPING ENTRY LOCKSET WEATHER-STRIPPING ENTRY LOCKSET WEATHER-STRIPPING PASSAGE BATHROOM LOCKSET DUMMY KNOBS BALL CATCHES ENTRY WITH MORTISE, SELF CLOSING HINGES	KEYPADS, REMOTE ALUMINUM SILL ALUMINUM SILL ALUMINUM SILL ALUMINUM SILL CLABEL FIRE RATED AND FRAME
004 005 006 100 101 102 103 104 105 106 200 201 202	ENTRY ENTRY ENTRY ENTRY EAUNDRY FAMILY ROOM DINING ROOM CLOSET BATHROOM CLOSET GCLOSET	3'-0" x 6'-8" x $1\frac{3}{4}$ " EXISTING EXISTING FWG 120611 12'-0" x 6'-11" FWG 100611 9'-9 3/4" x 6'-11" 4 PANEL (2)1'-8" x 6'-8" x $1\frac{3}{4}$ " 6 PANEL 2'-4" x 6'-8" x $1\frac{3}{4}$ " 12'-6" x 6'-8" 4 PANEL 2'-4" x 6'-8" x $1\frac{3}{4}$ " 6 PANEL 2'-4" x 6'-8" x $1\frac{3}{4}$ " 5'-0" x 6'-8" x $1\frac{3}{4}$ "	ENTRY ENTRY QUAD GLIDER QUAD GLIDER QUAD GLIDER DOUBLE SINGLE SINGLE SINGLE SINGLE BARN BI-FOLD BI-FOLD SINGLE	WOOD / GLASS WOOD / GLASS WOOD / GLASS MDF MDF IG MDF IG MDF IG T.B.D. IG T.B.D. IG T.B.D.	WOOD WOOD WOOD WOOD WOOD WOOD WOOD WOOD	WOOD WOOD WOOD WOOD WOOD WOOD WOOD WOOD	ENTRY LOCKSET WEATHER-STRIPPING ENTRY LOCKSET WEATHER-STRIPPING ENTRY LOCKSET WEATHER-STRIPPING PASSAGE BATHROOM LOCKSET DUMMY KNOBS BALL CATCHES ENTRY WITH MORTISE, SELF CLOSING HINGES THUMB PULL BEDROOM LOCKSET	KEYPADS, REMOTE ALUMINUM SILL ALUMINUM SILL ALUMINUM SILL ALUMINUM SILL CLABEL FIRE RATEE AND FRAME CLABEL FIRE RATEE
004 005 006 100 101 102 103 104 105 106 200 201	ENTRY	3'-0" x 6'-8" x 1 $\frac{3}{4}$ " EXISTING EXISTING FWG 120611 12'-0" x 6'-11" FWG 100611 9'-9 3/4" x 6'-11" 4 PANEL (2)1'-8" x 6'-8" x 1 $\frac{3}{4}$ " 6 PANEL 2'-4" x 6'-8" x 1 $\frac{3}{4}$ " 12'-6" x 6'-8" 4 PANEL 2'-4" x 6'-8" x 1 $\frac{3}{4}$ " 6 PANEL 2'-4" x 6'-8" x 1 $\frac{3}{4}$ " 5'-0" x 6'-8" x 1 $\frac{3}{4}$ " 6 PANEL 2'-8" x 6'-8" x 1 $\frac{3}{4}$ " 6 PANEL 2'-8" x 6'-8" x 1 $\frac{3}{4}$ " 6 PANEL 2'-8" x 6'-8" x 1 $\frac{3}{4}$ "	ENTRY ENTRY QUAD GLIDER QUAD GLIDER QUAD GLIDER DOUBLE SINGLE TRIMMED OPENIN SINGLE SINGLE TRIMMED OPENIN BARN BI-FOLD TRIMMED OPENIN	WOOD / GLASS WOOD / GLASS WOOD / GLASS MDF MDF IG MDF IG MDF IG T.B.D. IG T.B.D. IG T.B.D.	WOOD WOOD WOOD WOOD WOOD WOOD WOOD WOOD	WOOD WOOD WOOD WOOD WOOD WOOD WOOD WOOD	ENTRY LOCKSET WEATHER-STRIPPING ENTRY LOCKSET WEATHER-STRIPPING ENTRY LOCKSET WEATHER-STRIPPING PASSAGE BATHROOM LOCKSET DUMMY KNOBS BALL CATCHES ENTRY WITH MORTISE, SELF CLOSING HINGES THUMB PULL	KEYPADS, REMOTE         ALUMINUM SILL         ALUMINUM SILL         ALUMINUM SILL         ALUMINUM SILL         ALUMINUM SILL         ALUMINUM SILL         CLABEL FIRE RATED         BI-FOLD         BI-FOLD
004 005 006 100 101 102 103 104 105 106 200 201 202	ENTRY ENTRY ENTRY ENTRY EAUNDRY FAMILY ROOM DINING ROOM CLOSET BATHROOM CLOSET GCLOSET	3'-0" x 6'-8" x $1\frac{3}{4}$ " EXISTING EXISTING FWG 120611 12'-0" x 6'-11" FWG 100611 9'-9 3/4" x 6'-11" 4 PANEL (2)1'-8" x 6'-8" x $1\frac{3}{4}$ " 6 PANEL 2'-4" x 6'-8" x $1\frac{3}{4}$ " 12'-6" x 6'-8" 4 PANEL 2'-4" x 6'-8" x $1\frac{3}{4}$ " 6 PANEL 2'-4" x 6'-8" x $1\frac{3}{4}$ " 5'-0" x 6'-8" x $1\frac{3}{4}$ " 6 PANEL 2'-8" x $1\frac{3}{4}$ " 6 PANEL 2'-8" x $1\frac{3}{4}$ " 6 PANEL 2'-8" x $1\frac{3}{4}$ "	ENTRY ENTRY QUAD GLIDER QUAD GLIDER QUAD GLIDER DOUBLE SINGLE SINGLE SINGLE SINGLE BARN BI-FOLD BI-FOLD SINGLE	WOOD / GLASS WOOD / GLASS WOOD / GLASS MDF MDF IG MDF IG MDF IG T.B.D. IG T.B.D. IG T.B.D.	WOOD WOOD WOOD WOOD WOOD WOOD WOOD WOOD	WOOD WOOD WOOD WOOD WOOD WOOD WOOD WOOD	ENTRY LOCKSET WEATHER-STRIPPING ENTRY LOCKSET WEATHER-STRIPPING ENTRY LOCKSET WEATHER-STRIPPING PASSAGE BATHROOM LOCKSET DUMMY KNOBS BALL CATCHES ENTRY WITH MORTISE, SELF CLOSING HINGES THUMB PULL BEDROOM LOCKSET DUMMY KNOBS	KEYPADS, REMOTE ALUMINUM SILL ALUMINUM SILL ALUMINUM SILL MARBLE SADDLE C LABEL FIRE RATEE AND FRAME
004 005 006 100 101 102 103 104 105 106 200 201 202 203	ENTRY ENTRY ENTRY ENTRY ENTRY ENTRY FAMILY ROOM FAMILY ROOM CLOSET CLOSET GUUDY CLOSET GUUDROOM GUUDRO	3'-0" x 6'-8" x 1 $\frac{3}{4}$ " EXISTING EXISTING FWG 120611 12'-0" x 6'-11" FWG 100611 9'-9 3/4" x 6'-11" 4 PANEL (2)1'-8" x 6'-8" x 1 $\frac{3}{4}$ " 6 PANEL 2'-4" x 6'-8" x 1 $\frac{3}{4}$ " 12'-6" x 6'-8" 4 PANEL 2'-4" x 6'-8" x 1 $\frac{3}{4}$ " 6 PANEL 2'-4" x 6'-8" x 1 $\frac{3}{4}$ " 5'-0" x 6'-8" x 1 $\frac{3}{4}$ " 6 PANEL 2'-8" x 6'-8" x 1 $\frac{3}{4}$ "	ENTRY ENTRY QUAD GLIDER QUAD GLIDER QUAD GLIDER DOUBLE DOUBLE SINGLE SINGLE SINGLE SINGLE BARN BI-FOLD BI-FOLD SINGLE DOUBLE	WOOD / GLASS WOOD / GLASS WOOD / GLASS MDF MDF IG MDF IG MDF IG T.B.D. T.B.D. IG T.B.D. IG T.B.D.	WOOD WOOD WOOD WOOD WOOD WOOD WOOD WOOD	WOOD       I         WOOD       I <td< td=""><td>ENTRY LOCKSET WEATHER-STRIPPING ENTRY LOCKSET WEATHER-STRIPPING ENTRY LOCKSET WEATHER-STRIPPING PASSAGE BATHROOM LOCKSET DUMMY KNOBS BALL CATCHES ENTRY WITH MORTISE, SELF CLOSING HINGES THUMB PULL BEDROOM LOCKSET DUMMY KNOBS BALL CATCHES</td><td>KEYPADS, REMOTE         ALUMINUM SILL         ALUMINUM SILL         ALUMINUM SILL         ALUMINUM SILL         ALUMINUM SILL         ALUMINUM SILL         CLABEL FIRE RATEL         AND FRAME         BI-FOLD</td></td<>	ENTRY LOCKSET WEATHER-STRIPPING ENTRY LOCKSET WEATHER-STRIPPING ENTRY LOCKSET WEATHER-STRIPPING PASSAGE BATHROOM LOCKSET DUMMY KNOBS BALL CATCHES ENTRY WITH MORTISE, SELF CLOSING HINGES THUMB PULL BEDROOM LOCKSET DUMMY KNOBS BALL CATCHES	KEYPADS, REMOTE         ALUMINUM SILL         ALUMINUM SILL         ALUMINUM SILL         ALUMINUM SILL         ALUMINUM SILL         ALUMINUM SILL         CLABEL FIRE RATEL         AND FRAME         BI-FOLD
004 005 006 100 101 102 103 104 105 106 200 201 200 201 202 203 204 205	ENTRY	3'-0" x 6'-8" x 1 $\frac{3}{4}$ " EXISTING EXISTING FWG 120611 12'-0" x 6'-11" FWG 100611 9'-9 3/4" x 6'-11" 4 PANEL (2)1'-8" x 6'-8" x 1 $\frac{3}{4}$ " 6 PANEL 2'-4" x 6'-8" x 1 $\frac{3}{4}$ " 12'-6" x 6'-8" 4 PANEL 2'-4" x 6'-8" x 1 $\frac{3}{4}$ " 6 PANEL 2'-4" x 6'-8" x 1 $\frac{3}{4}$ " 5'-0" x 6'-8" x 1 $\frac{3}{4}$ " 6 PANEL 2'-8" x 6'-8" x 1 $\frac{3}{4}$ "	ENTRY ENTRY QUAD GLIDER QUAD GLIDER QUAD GLIDER DOUBLE SINGLE SINGLE SINGLE SINGLE BARN BI-FOLD BI-FOLD TRIMMED OPENIN BI-FOLD SINGLE SINGLE SINGLE SINGLE	WOOD / GLASS WOOD / GLASS MDF MDF MDF MDF MDF MDF MDF MDF MDF MDF	WOOD WOOD WOOD WOOD WOOD WOOD WOOD WOOD	WOOD         WOOD <t< td=""><td>ENTRY LOCKSET WEATHER-STRIPPING ENTRY LOCKSET WEATHER-STRIPPING ENTRY LOCKSET WEATHER-STRIPPING PASSAGE BATHROOM LOCKSET DUMMY KNOBS BALL CATCHES ENTRY WITH MORTISE, SELF CLOSING HINGES THUMB PULL BEDROOM LOCKSET DUMMY KNOBS BALL CATCHES BATHROOM LOCKSET</td><td>KEYPADS, REMOTE ALUMINUM SILL ALUMINUM SILL ALUMINUM SILL ALUMINUM SILL CLABEL FIRE RATED BI-FOLD BI-FOLD</td></t<>	ENTRY LOCKSET WEATHER-STRIPPING ENTRY LOCKSET WEATHER-STRIPPING ENTRY LOCKSET WEATHER-STRIPPING PASSAGE BATHROOM LOCKSET DUMMY KNOBS BALL CATCHES ENTRY WITH MORTISE, SELF CLOSING HINGES THUMB PULL BEDROOM LOCKSET DUMMY KNOBS BALL CATCHES BATHROOM LOCKSET	KEYPADS, REMOTE ALUMINUM SILL ALUMINUM SILL ALUMINUM SILL ALUMINUM SILL CLABEL FIRE RATED BI-FOLD BI-FOLD
004 005 006 100 101 102 103 104 105 106 200 201 200 201 202 203	ENTRY ENTRY ENTRY ENTRY ENTRY ENTRY FAMILY ROOM FAMILY ROOM DINING ROOM CLOSET CLOSET GUUDROOM GUUDROO	3'-0" x 6'-8" x 1 $\frac{3}{4}$ " EXISTING EXISTING FWG 120611 12'-0" x 6'-11" FWG 100611 9'-9 3/4" x 6'-11" 4 PANEL (2)1'-8" x 6'-8" x 1 $\frac{3}{4}$ " 6 PANEL 2'-4" x 6'-8" x 1 $\frac{3}{4}$ " 12'-6" x 6'-8" 4 PANEL 2'-4" x 6'-8" x 1 $\frac{3}{4}$ " 6 PANEL 2'-4" x 6'-8" x 1 $\frac{3}{4}$ " 5'-0" x 6'-8" x 1 $\frac{3}{4}$ " 6 PANEL 2'-8" x 6'-8" x 1 $\frac{3}{4}$ "	ENTRY ENTRY QUAD GLIDER QUAD GLIDER QUAD GLIDER DOUBLE DOUBLE SINGLE SINGLE SINGLE BARN BI-FOLD BARN BI-FOLD TRIMMED OPENIN BARN SINGLE SINGLE SINGLE SINGLE SINGLE	WOOD / GLASS WOOD / GLASS WOOD / GLASS MDF MDF MDF MDF MDF MDF MDF IG T.B.D. MDF IG T.B.D. MDF MDF IG MDF IG MDF IG MDF	WOOD SWOOD SWOOD SWOOD SWOOD PAINT	WOOD       I         WOOD       I <td< td=""><td>ENTRY LOCKSET WEATHER-STRIPPING ENTRY LOCKSET WEATHER-STRIPPING ENTRY LOCKSET WEATHER-STRIPPING PASSAGE BATHROOM LOCKSET DUMMY KNOBS BALL CATCHES ENTRY WITH MORTISE, SELF CLOSING HINGES THUMB PULL BEDROOM LOCKSET DUMMY KNOBS BALL CATCHES BATHROOM LOCKSET PASSAGE DUMMY KNOBS BALL CATCHES</td><td>KEYPADS, REMOTE ALUMINUM SILL ALUMINUM SILL ALUMINUM SILL ALUMINUM SILL CLABEL FIRE RATED BI-FOLD BI-FOLD</td></td<>	ENTRY LOCKSET WEATHER-STRIPPING ENTRY LOCKSET WEATHER-STRIPPING ENTRY LOCKSET WEATHER-STRIPPING PASSAGE BATHROOM LOCKSET DUMMY KNOBS BALL CATCHES ENTRY WITH MORTISE, SELF CLOSING HINGES THUMB PULL BEDROOM LOCKSET DUMMY KNOBS BALL CATCHES BATHROOM LOCKSET PASSAGE DUMMY KNOBS BALL CATCHES	KEYPADS, REMOTE ALUMINUM SILL ALUMINUM SILL ALUMINUM SILL ALUMINUM SILL CLABEL FIRE RATED BI-FOLD BI-FOLD
004 005 006 100 101 102 103 104 105 106 200 201 200 201 202 202 203 202 203	ENTRY	3'-0" x 6'-8" x 1 $\frac{3}{4}$ " EXISTING EXISTING FWG 120611 12'-0" x 6'-11" FWG 100611 9'-9 3/4" x 6'-11" 4 PANEL (2)1'-8" x 6'-8" x 1 $\frac{3}{4}$ " 6 PANEL 2'-4" x 6'-8" x 1 $\frac{3}{4}$ " 12'-6" x 6'-8" 4 PANEL 2'-4" x 6'-8" x 1 $\frac{3}{4}$ " 6 PANEL 2'-4" x 6'-8" x 1 $\frac{3}{4}$ " 5'-0" x 6'-8" x 1 $\frac{3}{4}$ " 6 PANEL 2'-8" x 6'-8" x 1 $\frac{3}{4}$ "	ENTRY ENTRY QUAD GLIDER QUAD GLIDER QUAD GLIDER DOUBLE SINGLE SINGLE SINGLE SINGLE BARN BI-FOLD BI-FOLD TRIMMED OPENIN BI-FOLD SINGLE SINGLE SINGLE SINGLE	WOOD / GLASS WOOD / GLASS MDF MDF MDF MDF MDF MDF MDF MDF MDF MDF	WOOD WOOD WOOD WOOD WOOD WOOD WOOD WOOD	WOOD         WOOD <t< td=""><td>ENTRY LOCKSET WEATHER-STRIPPING ENTRY LOCKSET WEATHER-STRIPPING ENTRY LOCKSET WEATHER-STRIPPING PASSAGE BATHROOM LOCKSET DUMMY KNOBS BALL CATCHES ENTRY WITH MORTISE, SELF CLOSING HINGES THUMB PULL BEDROOM LOCKSET DUMMY KNOBS BALL CATCHES BATHROOM LOCKSET PASSAGE DUMMY KNOBS</td><td>KEYPADS, REMOTE         ALUMINUM SILL         ALUMINUM SILL         ALUMINUM SILL         ALUMINUM SILL         ALUMINUM SILL         ALUMINUM SILL         CLABEL FIRE RATED         BI-FOLD         BI-FOLD</td></t<>	ENTRY LOCKSET WEATHER-STRIPPING ENTRY LOCKSET WEATHER-STRIPPING ENTRY LOCKSET WEATHER-STRIPPING PASSAGE BATHROOM LOCKSET DUMMY KNOBS BALL CATCHES ENTRY WITH MORTISE, SELF CLOSING HINGES THUMB PULL BEDROOM LOCKSET DUMMY KNOBS BALL CATCHES BATHROOM LOCKSET PASSAGE DUMMY KNOBS	KEYPADS, REMOTE         ALUMINUM SILL         ALUMINUM SILL         ALUMINUM SILL         ALUMINUM SILL         ALUMINUM SILL         ALUMINUM SILL         CLABEL FIRE RATED         BI-FOLD         BI-FOLD

### SOUTH WALL WEST WALL NORTH WALL EAST WALL ROOM NUMBER ROOM NAME FLOOR FINISH BASE MAT. FIN. MAT. FIN. MAT. MAT. FIN. FIN EPOXY FINISH ON GARAGE GYP. PAINT PAINT PAINT GYP. GYP. GYP. PAIN CONCRETE SLAB MUDROOM GYP. GYP. TILE WOOD GYP. PAINT GYP. PAINT PAINT PAIN HARDWOOD FLOORING EXERCISE ROOM WOOD GYP. GYP. GYP. PAINT PAINT GYP. PAINT PAIN HARDWOOD FLOORING FAMILY ROOM WOOD GYP. PAINT GYP. PAINT GYP. PAINT GYP. PAIN ENTRY GYP. PAINT GYP. PAINT GYP. PAINT GYP. PAIN BATHROOM TILE TILE GYP. PAINT GYP. PAINT GYP. PAINT GYP. PAIN HARDWOOD FLOORING PAINT GYP. KITCHEN WOOD GYP. GYP. GYP. PAINT PAINT PAIN EXISTING HARDWOOD LIVING ROOM WOOD GYP. PAINT GYP. PAINT PAINT PAIN GYP. GYP. FLOORING - REFINISHED EXISTING HARDWOOD DINING ROOM WOOD GYP. PAINT GYP. PAINT GYP. PAINT GYP. PAIN FLOORING - REFINISHED HARDWOOD FLOORING WOOD BEDROOM GYP. GYP. GYP. GYP. PAINT PAINT PAINT PAIN HARDWOOD FLOORING WOOD HALL GYP. PAINT GYP. PAINT GYP. PAINT GYP. PAIN HARDWOOD FLOORING OFFICE WOOD GYP. PAINT GYP. PAINT GYP. PAINT GYP. PAIN HARDWOOD FLOORING MASTER BEDROOM GYP. GYP. PAINT GYP. WOOD PAINT GYP. PAINT PAIN HARDWOOD FLOORING MASTER W.I.C. WOOD GYP. GYP. GYP. PAINT GYP. PAINT PAINT PAIN TILE MASTER BATHROOM TILE GYP. PAINT GYP. PAINT GYP. PAINT GYP. PAIN

FINISH SCHEDULE NOTES

FINISH SCHEDULE

1. ALL TILE OR STONE FLOORING TO BE SET ON THINSET OVER CEMENT BOARD, TYP. U.O.N.

1.1. ALL MARBLE TILE TO BE INSTALLED AS PER THE MARBLE INSTITUTE OF AMERICA, MARBLE TILE INSTALLATIONS REQUIRING A MUD SET TO BE COORDINATED WITH FRAMER TO DROP OR MODIFY FRAMING AS REQUIRED.

1.2. ALL NATURAL STONE TILE TO BE INSTALLED AS PER THE NATURAL STONE INSTITUTE OF AMERICA, NATURAL TILE INSTALLATIONS REQUIRING A MUD SET TO BE COORDINATED WITH FRAMER TO DROP OR MODIFY FRAMING AS


REQUIRED. 1.3. ALL CERAMIC & PORCELIN TILE TO BE INSTALLED AS PER THE NATIONAL TILE COUNCIL OF NORTH AMERICA, TILE TO BE INSTALLED ON THINSET AND UNCOUPLING AND WATERPROOF MEMBRANE DITRA OR DITRA-XL BY SCHLUTER OR

APPROIVED EQUAL. 2. ALL TILE, MARBLE SADDLES AND COUNTERTOPS TO BE SUPPLIED BY OWNER AND INSTALLED BY CONTRACTOR.

3. HARDWOOD FLOORING TO BE 2 1/4" OAK HARDWOOD FLOORING TO MATCH EXISTING WITH MINIMAL SHORT PIECES. INSTALLED, SANDED PLUS 1 COAT NATURAL STAIN & 3 COATS OIL BASED POLYURETHENE.


4. ALL SURFACES AND FINISHES TO RECEIVE PRIMER IN STRICT ACCORDANCE WITH PAINT MANUFACTURER'S


RECOMMENDATIONS. RECOAT AS REQUIRED FOR PROPER COVERAGE. 5. \* PATCH TO MATCH ALL CEILINGS DAMAGED BY NEW CONSTRUCTION

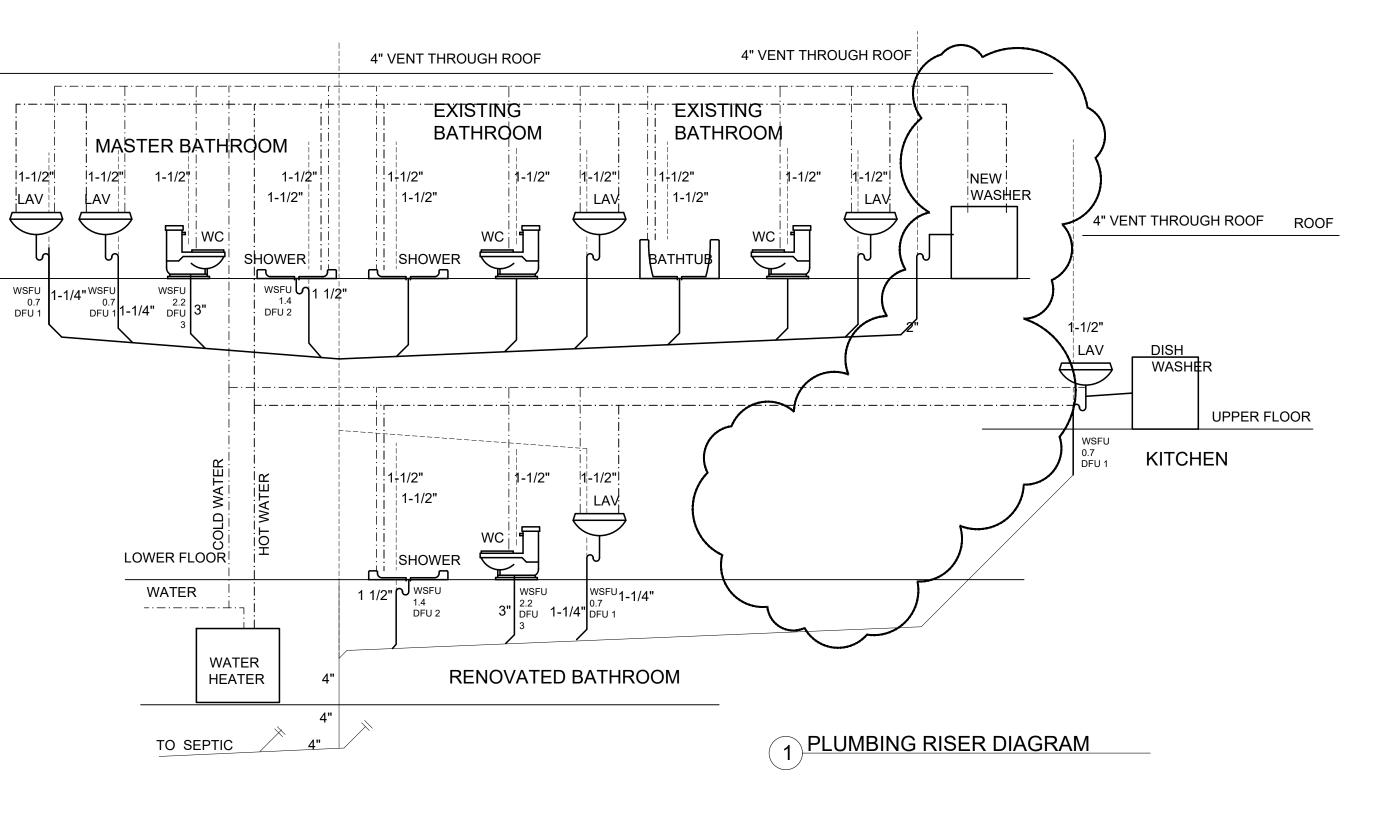



۷.	CEILING	REMARKS
INT	GYP. BD. PAINTED	ALL GYP. BD. TO BE <sup>5</sup> /8" FIRECODE TYPE 'X'
INT	GYP. BD. PAINTED	
INT		
INT	GYP. BD. PAINTED	
INT	GYP. BD. PAINTED	
INT	GYP. BD. PAINTED	
INT		
INT	GYP. BD. PAINTED	

HDWD. = CLEAR SELECT WHITE OAK HARDWOOD FLOORING GYP. = GYPSUM WALLBOARD CEM. = CEMENT BOARD

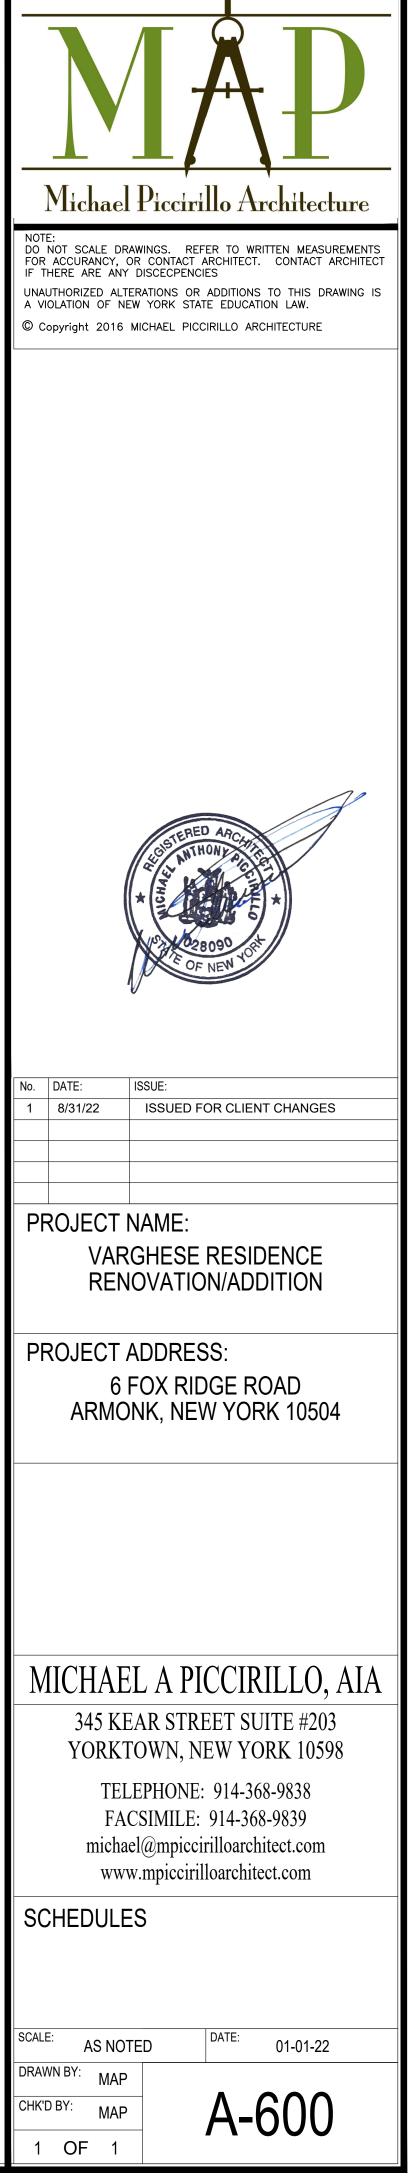

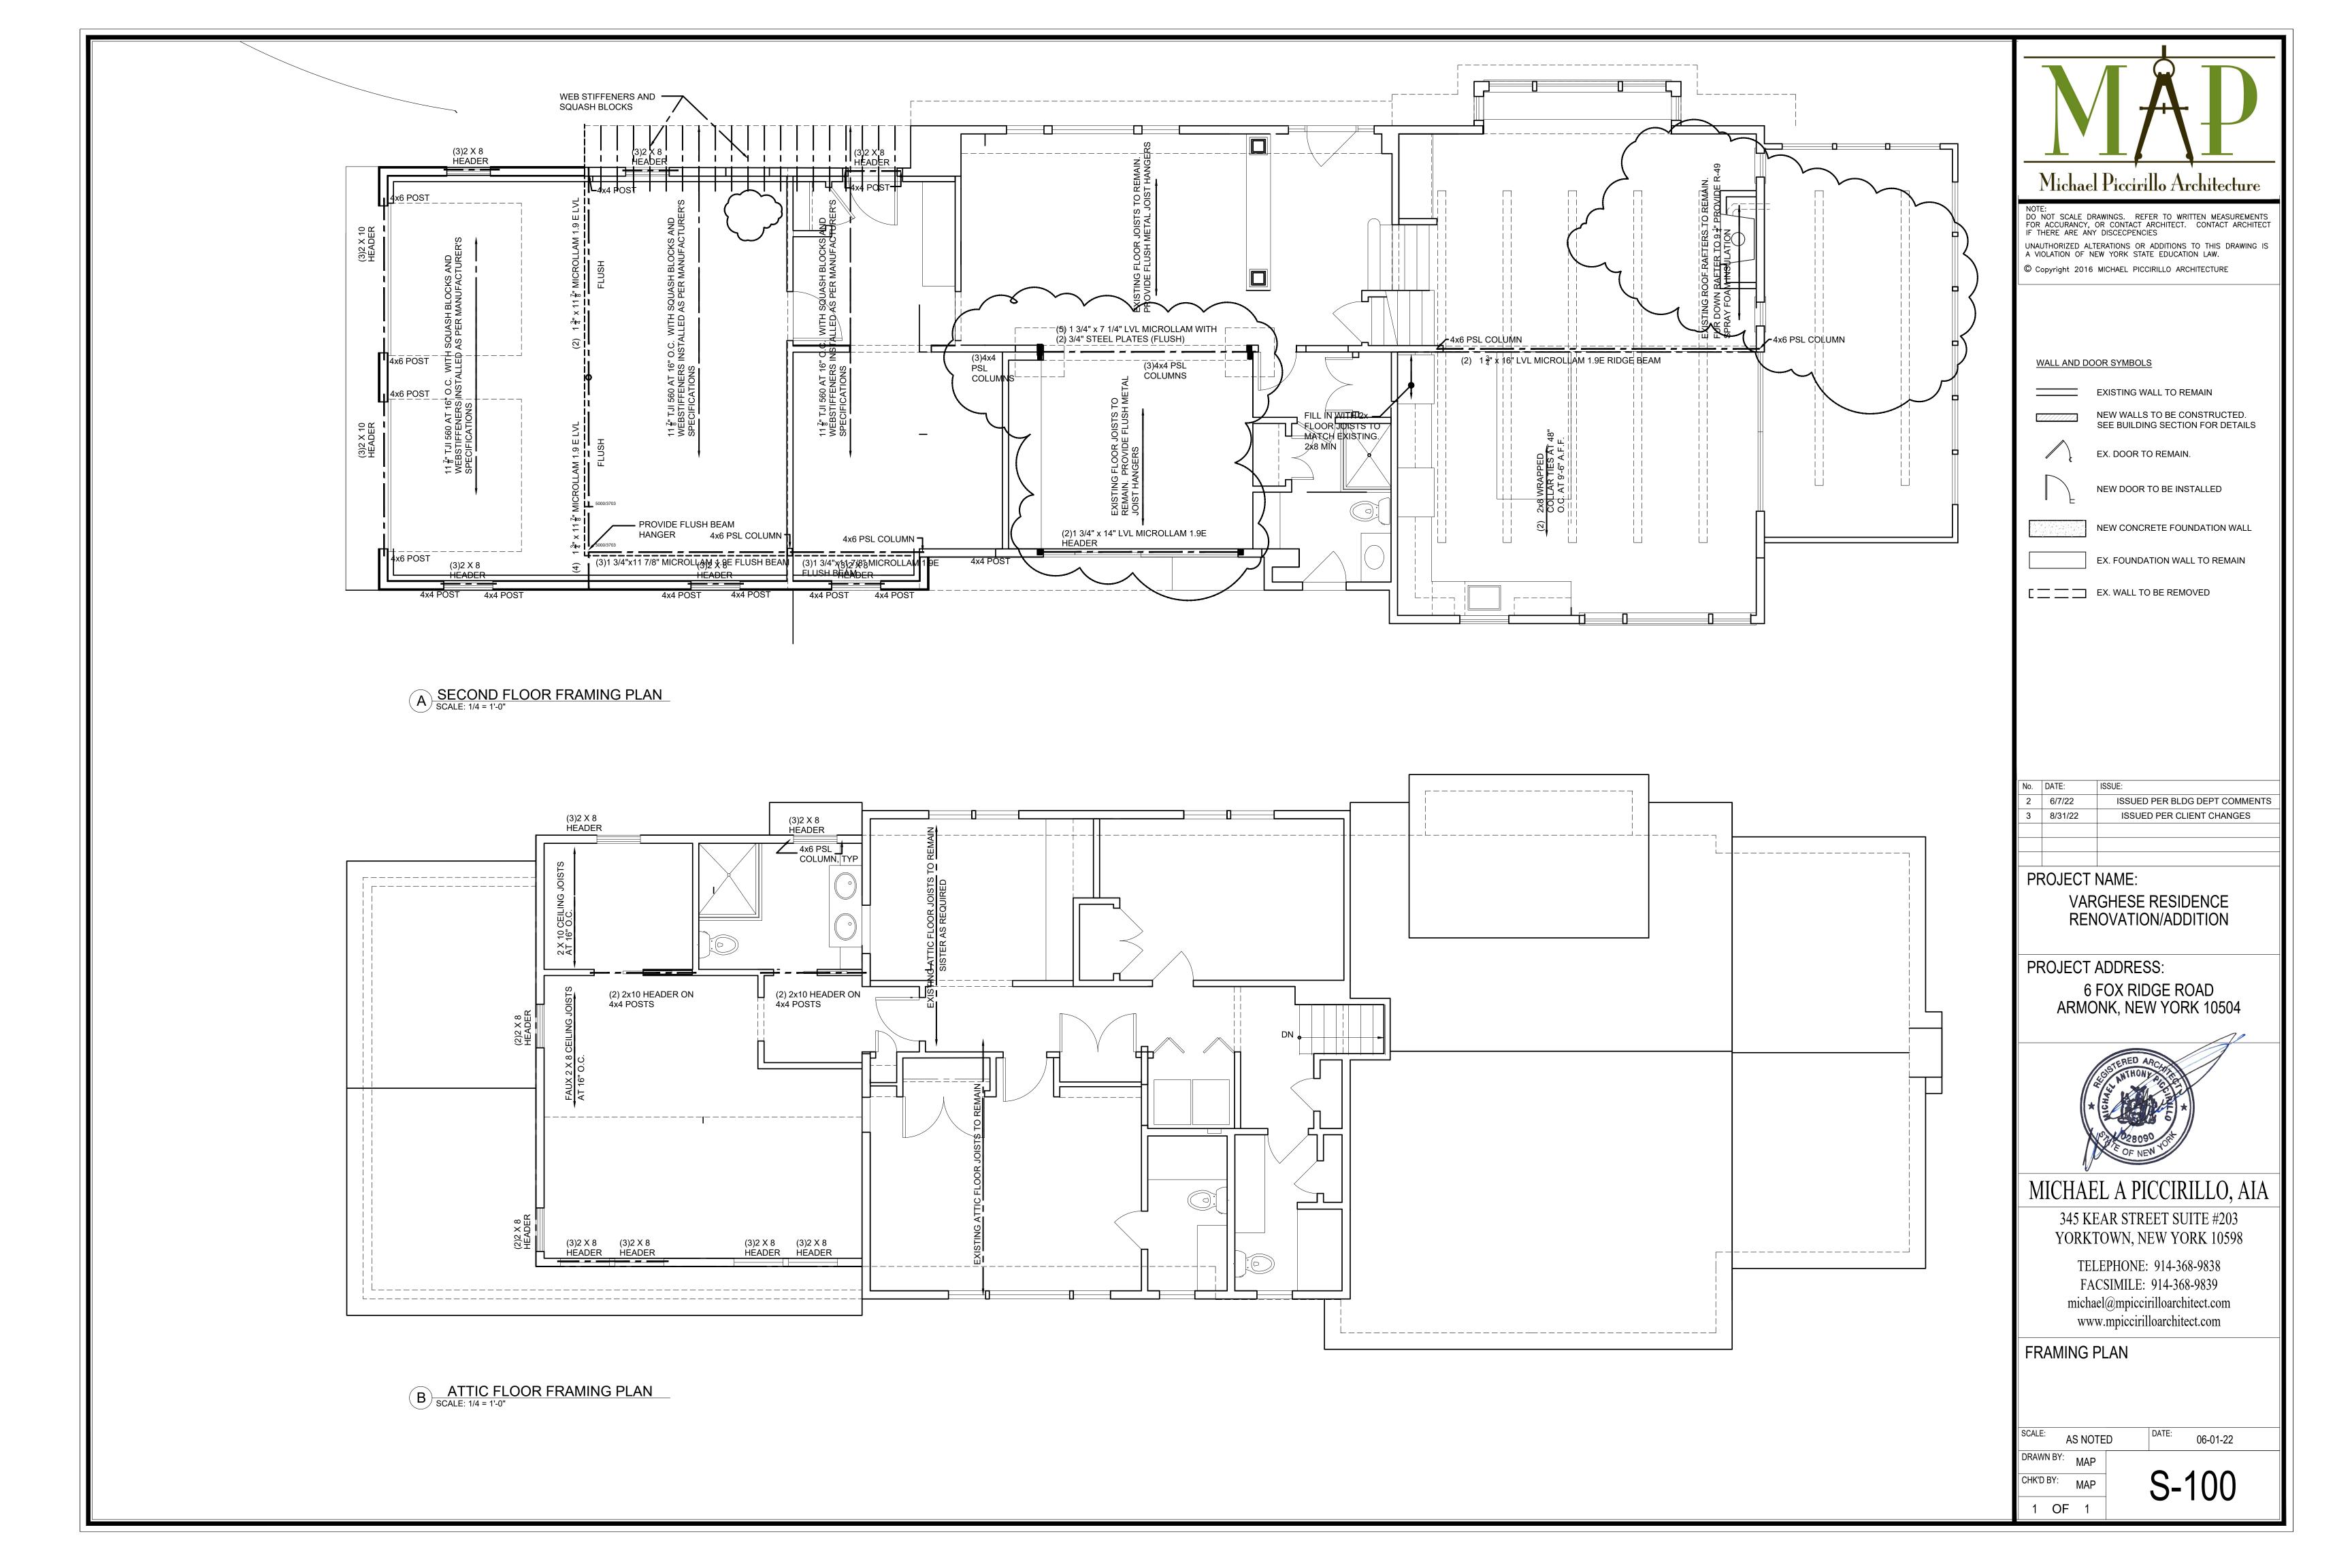

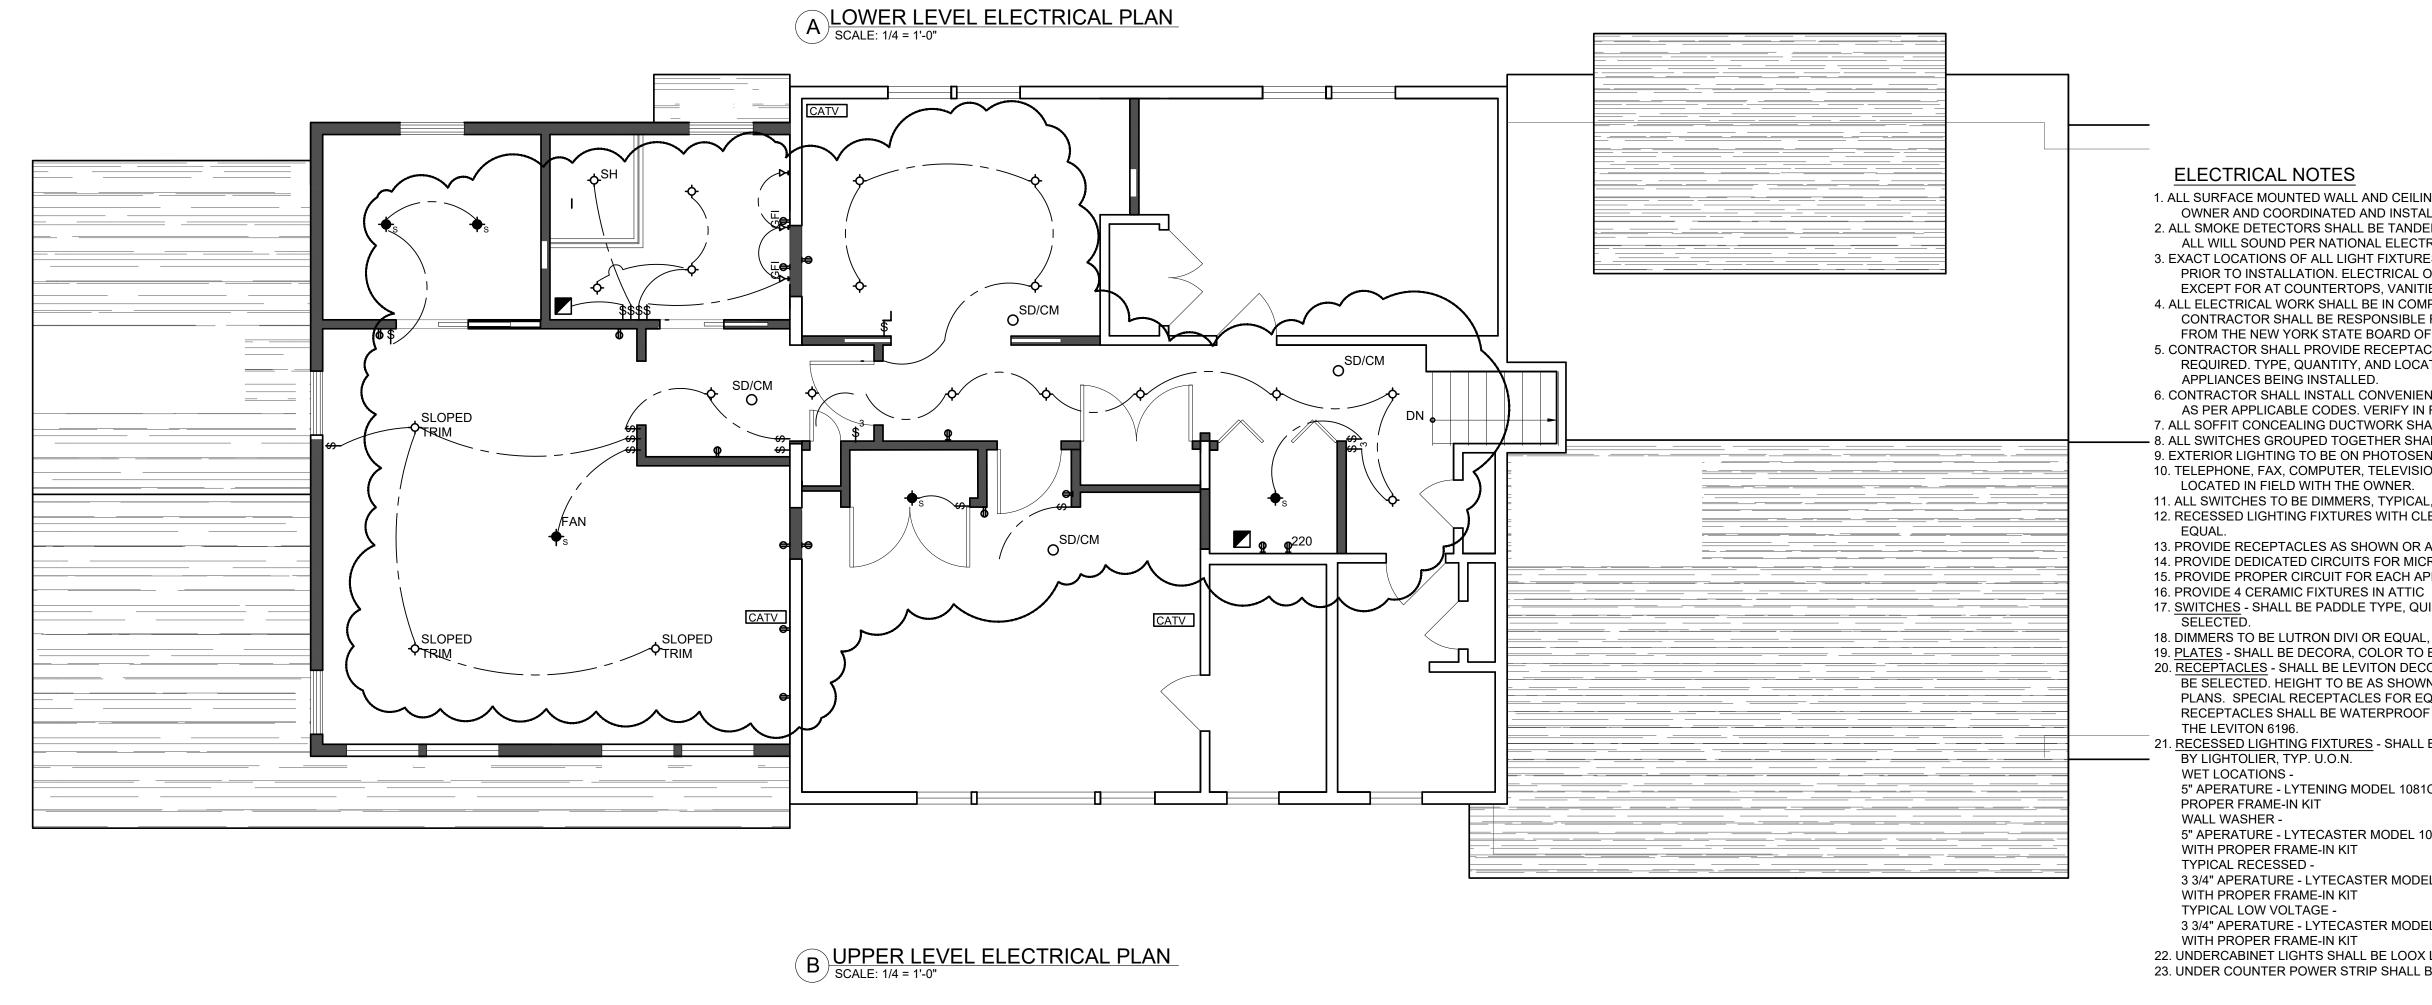

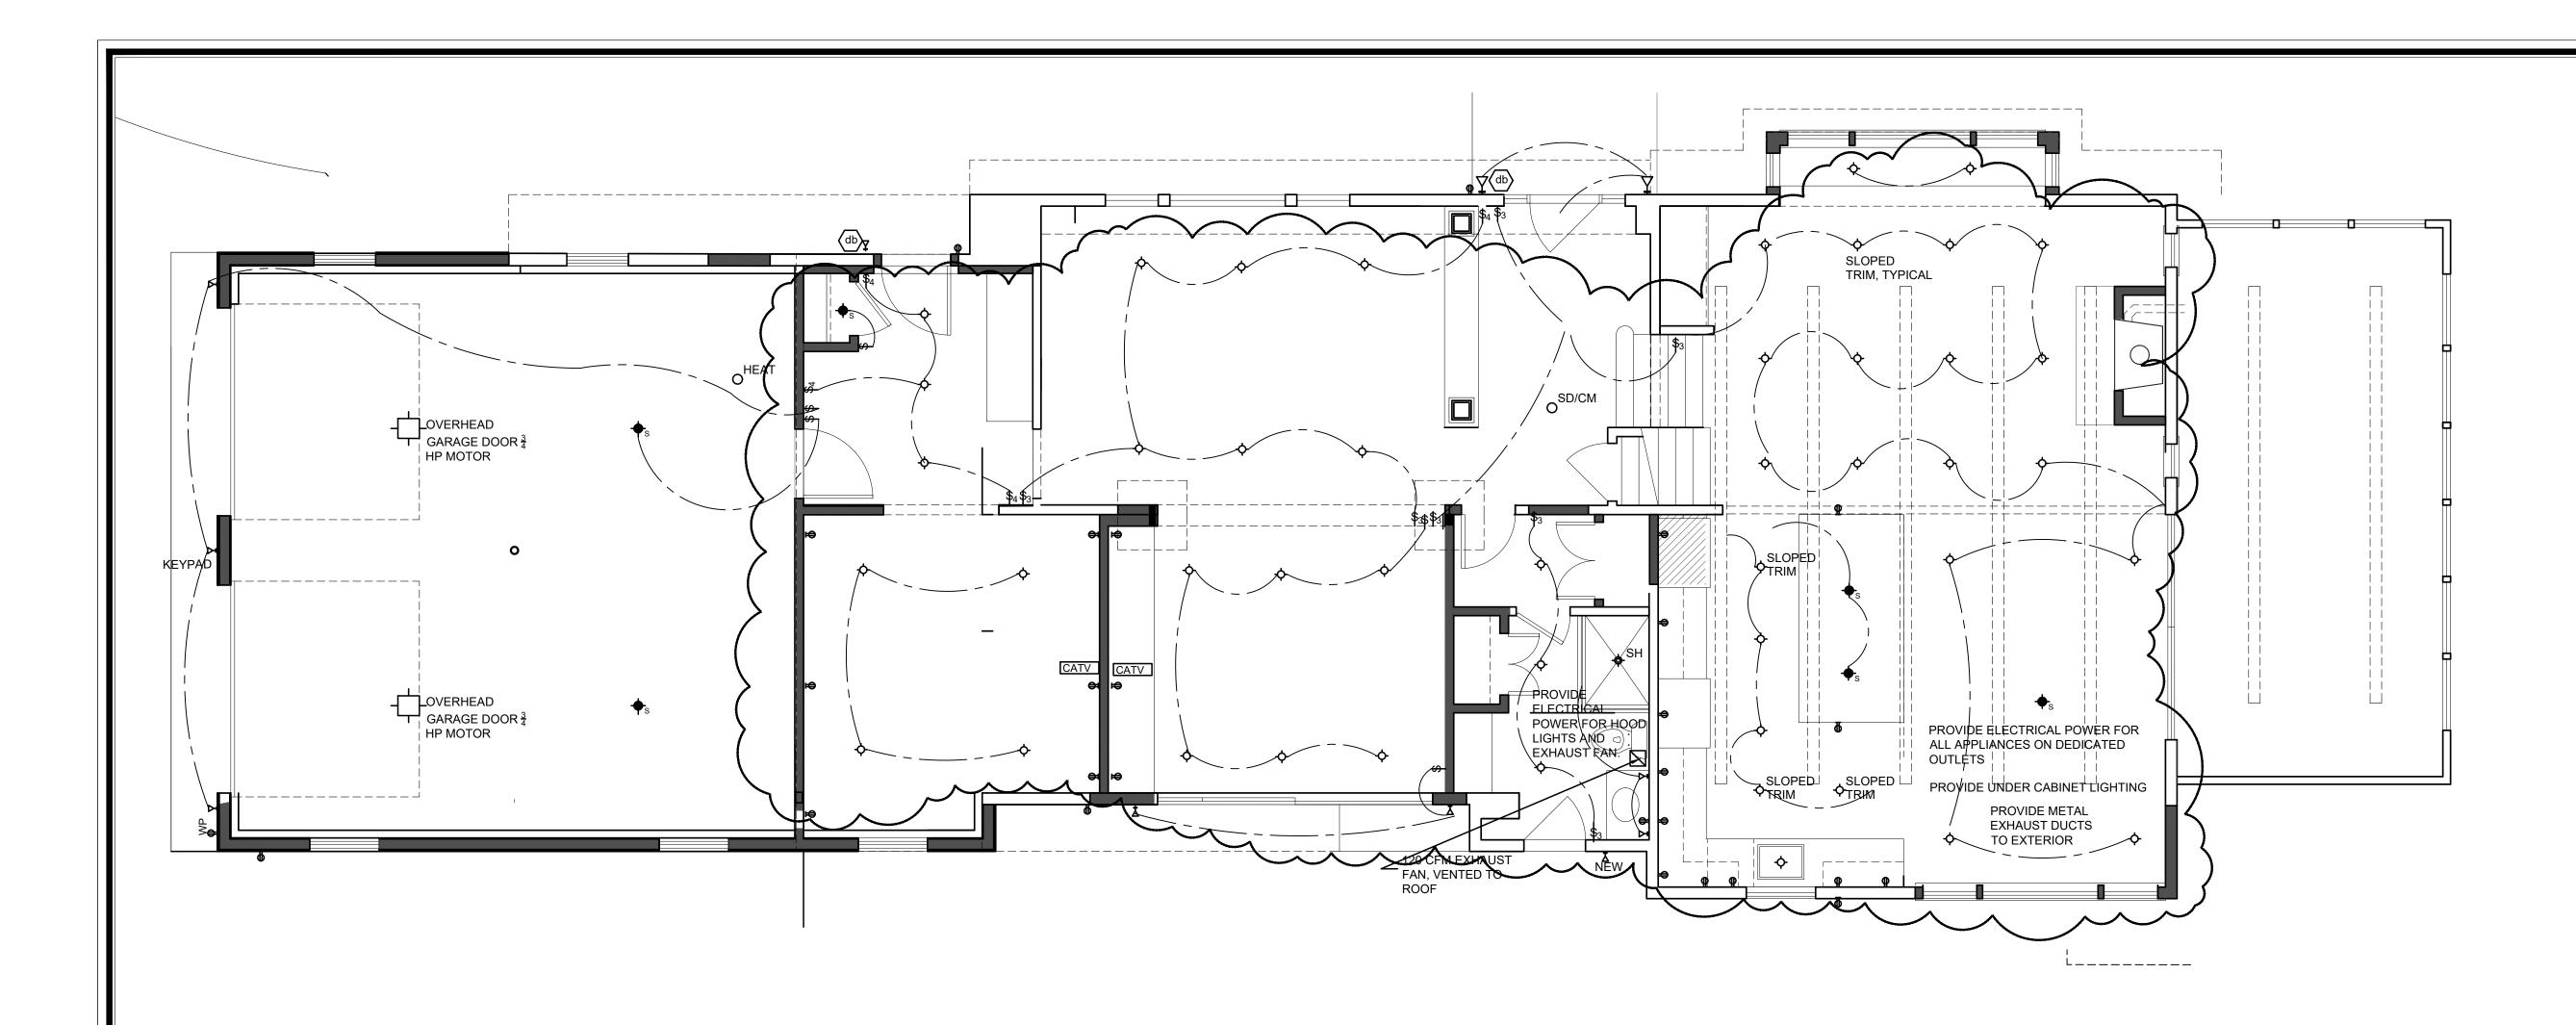

## ELECTRICAL NOTES

1. ALL SURFACE MOUNTED WALL AND CEILING LIGHT FIXTURES SHALL BE PURCHASED BY THE OWNER AND COORDINATED AND INSTALLED BY CONTRACTOR.

2. ALL SMOKE DETECTORS SHALL BE TANDEM HARD WIRED SUCH THAT WHEN ONE SOUNDS, ALL WILL SOUND PER NATIONAL ELECTRICAL CODE, LOCAL CODE, NFPA 72. 3. EXACT LOCATIONS OF ALL LIGHT FIXTURES SHALL BE REVIEWED WITH THE OWNER ON SITE PRIOR TO INSTALLATION. ELECTRICAL OUTLETS SHALL INSTALLED TO MATCH EXISTING,

EXCEPT FOR AT COUNTERTOPS, VANITIES, AND AS OTHERWISE NOTED. 4. ALL ELECTRICAL WORK SHALL BE IN COMPLIANCE WITH APPLICABLE CODES. THE CONTRACTOR SHALL BE RESPONSIBLE FOR COMPLIANCE AND FOR OBTAINING CERTIFICATE

FROM THE NEW YORK STATE BOARD OF FIRE UNDERWRITERS. 5. CONTRACTOR SHALL PROVIDE RECEPTACLES / POWER TO ALL MAJOR APPLIANCES AS REQUIRED. TYPE, QUANTITY, AND LOCATIONS SHALL BE COORDINATED WITH THE SPECIFIC

APPLIANCES BEING INSTALLED. 6. CONTRACTOR SHALL INSTALL CONVENIENCE OUTLETS IN ALL ROOMS, INCLUDING HALLWAYS

AS PER APPLICABLE CODES. VERIFY IN FIELD. 7. ALL SOFFIT CONCEALING DUCTWORK SHALL BE BUILT TO THE HIGHEST POSSIBLE.

– 8. ALL SWITCHES GROUPED TOGETHER SHALL BE GANGED ON ONE SWITCH PLATE.

9. EXTERIOR LIGHTING TO BE ON PHOTOSENSOR/SWITCH 10. TELEPHONE, FAX, COMPUTER, TELEVISION, AND OTHER COMMUNICATION WIRING TO BE

LOCATED IN FIELD WITH THE OWNER. 11. ALL SWITCHES TO BE DIMMERS, TYPICAL, U.O.N., EXCEPT OVER COUNTERTOP

12. RECESSED LIGHTING FIXTURES WITH CLEAR TRIM BY LIGHTOLIER, TYP. U.O.N. OR APPROVE 13. PROVIDE RECEPTACLES AS SHOWN OR AT MIMINUM CODE REQUIREMENTS

14. PROVIDE DEDICATED CIRCUITS FOR MICROWAVE, TOSTER OVEN, ETC 15. PROVIDE PROPER CIRCUIT FOR EACH APPLIANCE.

17. SWITCHES - SHALL BE PADDLE TYPE, QUIET TYPE BY LEVITON OR EQUAL, COLOR TO BE

18. DIMMERS TO BE LUTRON DIVI OR EQUAL, COLOR TO BE SELECTED.

19. PLATES - SHALL BE DECORA, COLOR TO BE SELECTED. 20. RECEPTACLES - SHALL BE LEVITON DECORA LINE OR EQUAL DUPLEX GROUNDED, COLOR TO BE SELECTED. HEIGHT TO BE AS SHOWN OR AS DIRECTED BY ARCHITECT OR SHOWN ON PLANS. SPECIAL RECEPTACLES FOR EQUIPMENT AS SHOWN ON THE DRAWINGS. EXTERIOR RECEPTACLES SHALL BE WATERPROOF TYPE WITH GASKETED SPRING COVERS EQUAL TO

21. <u>RECESSED LIGHTING FIXTURES</u> - SHALL BE 4 1/2" DIA. RECESSED FIXTURES WITH CLEAR TRIM BY LIGHTOLIER, TYP. U.O.N.

5" APERATURE - LYTENING MODEL 1081CD WITH FINISH: CLEAR DIFFUSE COORDINATE WITH

5" APERATURE - LYTECASTER MODEL 1085 WITH FINISH: PERMAWHITE DIFFUSE COORDINATE WITH PROPER FRAME-IN KIT

3 3/4" APERATURE - LYTECASTER MODEL 2013CD WITH FINISH: CLEAR DIFFUSE COORDINATE WITH PROPER FRAME-IN KIT

3 3/4" APERATURE - LYTECASTER MODEL 2000LV WITH FINISH: CLEAR DIFFUSE. COORDINATE WITH PROPER FRAME-IN KIT 22. UNDERCABINET LIGHTS SHALL BE LOOX LED 3006, MANUFACTURED BY HAFELE.

23. UNDER COUNTER POWER STRIP SHALL BE WIREMOLD PLUGMOLD, HARDWIRED

	P				
Michael Piccirillo 2	Architecture				
NOTE: DO NOT SCALE DRAWINGS. REFER TO FOR ACCURANCY, OR CONTACT ARCHITE IF THERE ARE ANY DISCECPENCIES UNAUTHORIZED ALTERATIONS OR ADDITIO A VIOLATION OF NEW YORK STATE EDU © Copyright 2021 MICHAEL PICCIRILLO <u>ELECTRICAL LEGEND</u> 220 VOLT WALL REC	ECT. CONTACT ARCHITECT DNS TO THIS DRAWING IS CATION LAW. ARCHITECTURE PLLC				
Image: Mathematical system     New Wall Recept.       Image: Mathematical system     Image: Mathematical system       Image: Mathematical system     Imag	AT 48" A.F.F.				
₩P       WEATHER PROOF/G         ₩       FLOOR OUTLET REG         ₩       GROUND FAULT REG	CEPTACLE				
	IXTURE				
+Q-       Wall MOUNTED LIG         +Q-       Wall MOUNTED LIG         WALL MOUNTED LIG       With Lense, in CLC         PORCELAIN LIGHT F       SCONCE	GHT FIXTURE DSET				
SCONCE SINGLE POLE SWITC S <sup>3</sup> THREE WAY SWITCH S <sup>J</sup> JAMB SWITCH					
Image: New 140 CFM EXHA       PANASONIC WITH H       JOHNSON CONTROL       CATV       NEW CABLE TELEVI       O <sub>H</sub> HEAT DETECTOR	UMIDISTAT BY -				
CARBON MONOXIDE HARD WIRED WITH DETECTOR	E / SMOKE DETECTOR BATTERY BACKUP				
REMOTE CONTROL O OPENER CEILING MOUNTED F					
No.         DATE:         ISSUE:           1         8/31/22         ISSUED FO	R CLIENT CHANGES				
PROJECT NAME: VARGHESE RESIDENCE RENOVATION/ADDITION					
PROJECT ADDRESS: 6 FOX RIDGE ROAD ARMONK, NEW YORK 10504					
A CONTRACTOR A DICCONDUCTOR ALA					
MICHAEL A PICCIRILLO, AIA 345 KEAR STREET SUITE #203 YORKTOWN, NEW YORK 10598					
TELEPHONE: 914-368-9838 FACSIMILE: 914-368-9839 michael@mpiccirilloarchitect.com www.mpiccirilloarchitect.com					
ELECTRICAL PLAN					
SCALE: AS NOTED DATE: DRAWN BY: MAP CHK'D BY: MAP	<sup>07-22-21</sup>				